

**ST. CLAIR COUNTY, MICHIGAN  
OFFICIAL GOVERNMENT CORNER**



**LAND CORNER RECORDATION CERTIFICATE  
Filing Requirement of Act 74, Mich. P.A. 1970**

	Located In:	Corner Code #
	Kimball Twp.	
1. Public Land Survey	T <u>6N.</u> R <u>16 E.</u>	<u>A-7</u>
	T _____ R _____	_____
	T _____ R _____	_____
	T _____ R _____	_____
2. Property Controlling	S _____ T _____ R _____	<u>Seg-1</u>
in Section	S _____ T _____ R _____	_____
3. Miscellaneous	S _____ T _____ R _____	_____
Property in Sec.	S _____ T _____ R _____	_____
4. Lot No. _____, Recorded Plat _____		
5. Private Claims _____		

RECEIVED  
1993 DEC 29 AM 9:02  
REGISTER OF DEEDS  
ST. CLAIR COUNTY, MICHIGAN  
Register of Deeds Stamp & File Number

I, John R. Lansky, in a field survey on Sept. 20-24, 1993, do hereby certify that under requirements of P.A. 74, Michigan P.A. of 1970, the corner points mentioned in lines 1 and 2 above were in conformance with regulations and rules therefore as required in the current manual of survey instructions of the United States Department of the Interior, Bureau of Land Management or by a decree of a Court of Law and/or that the corner points mentioned in lines 3, 4 and 5 above were in conformance with the rules of the Michigan Board of Land Surveyors or by a Decree of a Court of Law; established, re-established, monumented, re-monumented, recovered, found as expressed below:

A	B	C	D	E	F	G	H	I	J	K	L	M
2	6	5	4	3	2	1						
3												
4	7	8	9	10	11	12						
5												
6	18	17	16	15	14	13						
7												
8	19	20	21	22	23	24						
9												
10	30	29	28	27	26	25						
11												
12	31	32	33	34	35	36						
13												

**NOTE: Not more than 1 corner, may be recorded on this certificate.**

**A. Description of original monument and accessories and/or subsequent restoration:**

- 16" Lynn -- Per Original Gov't Survey
- Nothing Listed on Old Surveyor's Record  
St. Clair County for this corner.
- Ref. Cert. Filed L6 P.349 (RR. Spike)

**STATE PLAIN COORDINATES**

N. \_\_\_\_\_

E. \_\_\_\_\_

ELEVATION \_\_\_\_\_


**B. Description of corner evidence found and/or method applied in restoring or reestablishing corner:**

Set "T" Iron on Range Line Between N.E. Corner of Sec. 24, T.6N., R.15E., and East 1/4 Corner of Sec. 24, T.6N., R.15E. (Found R.R. Spike 0.35 ft. E.)

2159A000 12/29/93HSSU4 9.00  
\*\*000J\*\*  
2159A000 12/29/93SSRE4 2.00  
\*\*000J\*\*

**C. Description of monument for corner and accessories established to perpetuate locating the position of the corner:**

"T" Iron with Cap (RLS 18659)  
Westerly 30.30 ft. Set PK Nail & Tag in D.E. Pole  
W.N.W. 102.73 ft. " " " " "  
N.W. 70.60 ft. " " " in Guy Pole  
N'ly 31.14 ft. to N.E. Cor. Sec. 24 T.6N., R.15E.  
See attached sketch for additional information.

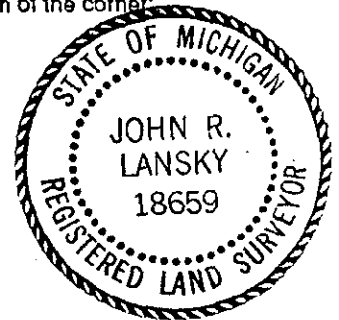

Signed by John R. Lansky  
Surveyor's Michigan License No. 18659

Date Sept. 29, 1993

PA 345-1990  
PEER COMMITTEE

APPROVED 11-16-93

APPROVED AS AN OFFICIAL GOVERNMENT CORNER BY ST. CLAIR COUNTY:

Signed By: \_\_\_\_\_ Date \_\_\_\_\_  
St. Clair County Land Surveyor

Surveyor's Michigan License No. \_\_\_\_\_