

**ST. CLAIR COUNTY, MICHIGAN
OFFICIAL GOVERNMENT CORNER**



**LAND CORNER RECORDATION CERTIFICATE
Filing Requirement of Act 74, Mich. P.A. 1970**

Located In: _____ Corner Code # _____

		Kimball Twp.		
1. Public Land Survey	T	6N.	R 16E.	A-7
	T	_____	R _____	_____
	T	_____	R _____	_____
	T	_____	R _____	_____
2. Property Controlling in Section	S	_____	T _____	R _____
	S	_____	T _____	R _____
3. Miscellaneous Property in Sec.	S	_____	T _____	R _____
	S	_____	T _____	R _____

RECEIVED
1995 AUG -4 AM 10:19
REGISTER OF DEEDS
ST. CLAIR COUNTY
Register of Deeds Stamp & File Number

4. Lot No. _____, Recorded Plat _____
5. Private Claims _____

A	B	C	D	E	F	G	H	I	J	K	L	M
2	6	5	4	3	2	1						
3												
4	7	8	9	10	11	12						
5												
6	18	17	16	15	14	13						
7												
8	19	20	21	22	23	24						
9												
10	30	29	28	27	26	25						
11												
12	31	32	33	34	35	36						
13												

Daniel E. Johnson **January 30** **95**
I, _____, in a field survey on _____, 19____, do hereby certify that under requirements of P.A. 74, Michigan P.A. of 1970, the corner points mentioned in lines 1 and 2 above were in conformance with regulations and rules therefore as required in the current manual of survey instructions of the United States Department of the Interior, Bureau of Land Management or by a decree of a Court of Law and/or that the corner points mentioned in lines 3, 4 and 5 above were in conformance with the rules of the Michigan Board of Land Surveyors or by a Decree of a Court of Law; established, re-established, monumented, re-monumented, recovered, found as expressed below:

NOTE: Not more than 1 corner, may be recorded on this certificate.

A. Description of original monument and accessories and/or subsequent restoration:

LIBER 007 PAGE 112


STATE PLAIN COORDINATES

N. _____
E. _____

B. Description of corner evidence found and/or method applied in restoring or reestablishing corner:

LIBER 007 PAGE 112

ELEVATION _____

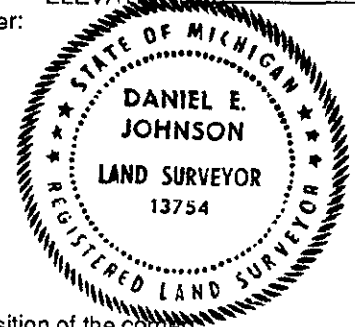

C. Description of monument for corner and accessories established to perpetuate locating the position of the corner:
Set 2" dia. aluminum cap inscribed "St. Clair County Official Corner" with magnet on a
"T" IRON WITH CAP (RLS 18659)
Westerly 30.30 ft. Set PK Nail & Tag in D.E. Pole
W.N.W. 102.73 ft. " " " " D.E. Pole
N.W. 70.60 ft. " " " " Guy Pole
N'y 31.14 ft. to N.E. Cor. Sec. 24 T.6N., R.15E.

Signed by *Daniel E. Johnson* Date January 30, 1995
Daniel E. Johnson
13754
Surveyor's Michigan License No. _____

**PA 345-1990
PEER COMMITTEE**

APPROVED AS AN OFFICIAL GOVERNMENT CORNER BY ST. CLAIR COUNTY:

APPROVED 11-16-93
David

Signed By: *Daniel E. Johnson* Date 7-31-95
St. Clair County Land Surveyor **Daniel E. Johnson**
13754
Surveyor's Michigan License No. _____

LIBER **008** PAGE **139**