

ST. CLAIR COUNTY, MICHIGAN OFFICIAL GOVERNMENT CORNER



LAND CORNER RECORDATION CERTIFICATE Filing Requirement of Act 74, Mich. P.A. 1970

Located In: _____ Corner Code # _____

Kimball Twp.

1. Public Land Survey	T <u>6N.</u> R <u>16E.</u>	_____	_____	_____	_____
	T _____	R _____	_____	_____	_____
	T _____	R _____	_____	_____	_____
	T _____	R _____	_____	_____	_____
2. Property Controlling in Section	S _____	T _____	R _____	_____	_____
	S _____	T _____	R _____	_____	_____
3. Miscellaneous Property in Sec.	S _____	T _____	R _____	_____	_____
	S _____	T _____	R _____	_____	_____

Seg. 2

RECEIVED
 REGISTER OF DEEDS
 ST. CLAIR COUNTY
 1995 AUG -4 AM 10:15
 Register of Deeds Stamp & File Number

4. Lot No. _____, Recorded Plat _____
 5. Private Claims _____

	A	B	C	D	E	F	G	H	I	J	K	L	M
2	6	5	4	3	2	1							
3													
4	7	8	9	10	11	12							
5													
6	18	17	16	15	14	13							
7													
8	19	20	21	22	23	24							
9													
10	30	29	28	27	26	25							
11													
12	31	32	33	34	35	36							
13													

Daniel E. Johnson **January 31** **95**

I, _____, in a field survey on _____, 19____, do hereby certify that under requirements of P.A. 74, Michigan P.A. of 1970, the corner points mentioned in lines 1 and 2 above were in conformance with regulations and rules therefore as required in the current manual of survey instructions of the United States Department of the Interior, Bureau of Land Management or by a decree of a Court of Law and/or that the corner points mentioned in lines 3, 4 and 5 above were in conformance with the rules of the Michigan Board of Land Surveyors or by a Decree of a Court of Law, established, re-established, monumented, re-monumented, recovered, found as expressed below:

NOTE: Not more than 1 corner, may be recorded on this certificate.

A. Description of original monument and accessories and/or subsequent restoration:

LIBER 007 PAGE 106

STATE PLAIN COORDINATES


N. _____

E. _____

ELEVATION _____

B. Description of corner evidence found and/or method applied in restoring or reestablishing corner:

LIBER 007 PAGE 106

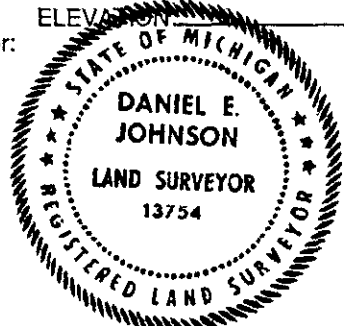

C. Description of monument for corner and accessories established to perpetuate locating the position of the corner:

Set 2" dia. aluminum cap inscribed "St. Clair County Official Corner" with magnet on a R.R. SPIKE,
 N.W. 56.45 ft. Set PK Nail & Tag in 5" Elm
 N.W. 77.23 ft. " " " D.E. Pole
 N.E. 54.76 ft. " " " 12" Elm

Signed by Daniel E. Johnson Date January 31, 1995
 Daniel E. Johnson
 13754

Surveyor's Michigan License No. _____
 PA 345-1990
 PEER COMMITTEE

APPROVED AS AN OFFICIAL GOVERNMENT CORNER BY ST. CLAIR COUNTY: APPROVED 11-16-93 *DWB*

Signed By: Daniel E. Johnson Date 7-31-95

St. Clair County Land Surveyor **Daniel E. Johnson**
 13754

Date
 LIBER **008** PAGE **137**

Surveyor's Michigan License No. _____