

ST. CLAIR COUNTY, MICHIGAN OFFICIAL GOVERNMENT CORNER



LAND CORNER RECORDATION CERTIFICATE
Filing Requirement of Act 74, Mich. P.A. 1970

Located In: Kimball Twp. Corner Code #

1. Public Land Survey	T	<u>6N</u>	R	<u>16E.</u>	<u>A-10</u>
	T	_____	R	_____	_____
	T	_____	R	_____	_____
	T	_____	R	_____	_____
2. Property Controlling in Section	S	_____	T	_____	<u>Sec. 1</u>
	S	_____	T	_____	_____
3. Miscellaneous Property in Sec.	S	_____	T	_____	_____
	S	_____	T	_____	_____

RECEIVED
REGISTER OF DEEDS
ST. CLAIR COUNTY
1993 DEC 29 AM 9:00
Register of Deeds Stamp & File Number

4. Lot No. _____, Recorded Plat _____
5. Private Claims _____

I, John R. Lansky in a field survey on Sept. 20, 1993 do hereby certify that under requirements of P.A. 74, Michigan P.A. of 1970, the corner points mentioned in lines 1 and 2 above were in conformance with regulations and rules therefore as required in the current manual of survey instructions of the United States Department of the Interior, Bureau of Land Management or by a decree of a Court of Law and/or that the corner points mentioned in lines 3, 4 and 5 above were in conformance with the rules of the Michigan Board of Land Surveyors or by a Decree of a Court of Law; established, re-established, monumented, re-monumented, recovered, found as expressed below:

	A	B	C	D	E	F	G	H	I	J	K	L	M
2	6	5	4	3	2	1							
3													
4	7	8	9	10	11	12							
5													
6	18	17	16	15	14	13							
7													
8	19	20	21	22	23	24							
9													
10	30	29	28	27	26	25							
11													
12	31	32	33	34	35	36							
13													

NOTE: Not more than 1 corner, may be recorded on this certificate.

A. Description of original monument and accessories and/or subsequent restoration:

This Corner was not set in Gov't Survey.
Nothing Listed on Old Surveyor's Record
St. Clair County for this corner.
No Certificate filed on this corner.

STATE PLAIN COORDINATES

N. _____

E. _____

ELEVATION _____

B. Description of corner evidence found and/or method applied in restoring or reestablishing corner:

Found Iron Rod with Cap RLS 19835


C. Description of monument for corner and accessories established to perpetuate locating the position of the corner:

Iron Rod With Cap RLS 19835

Easterly 15.50 Set PK Nail & County Tag in Utility Pole
N'yly 69 ft. to centerline of D.E. High Ten. Line Crossing (E.&W)
Northerly 30.96 ft. to East 1/4 Corner of Sec. 25 T.6N., R.15E.

See Attached sketch for additional information.

2159A000 12/29/93MSSU# 9.00
2188A000 12/29/93SSRE# 2.00
0001

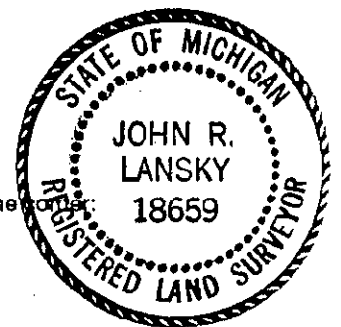

Signed by John R. Lansky
Surveyor's Michigan License No. 18659

Date Sept. 24, 1993

PA 345-1990
PEER COMMITTEE

APPROVED 11-16-93

APPROVED AS AN OFFICIAL GOVERNMENT CORNER BY ST. CLAIR COUNTY:

Signed By: _____
St. Clair County Land Surveyor