

REMONUMENTATION

ST. CLAIR COUNTY, MICHIGAN
OFFICIAL GOVERNMENT CORNER



DEC 02 1997

COMMISSION

LAND CORNER RECORDATION CERTIFICATE
Filing Requirement of Act 74, Mich. P.A. 1970

REGISTERED
ST. CLAIR COUNTY
1997 AUG 21 AM 7:25
RECORDED

Register of Deeds Stamp & File Number

	Located In:	Corner Code #
1. Public Land Survey	KIMBALL TWP. T <u>6N</u> R <u>16E</u>	<u>B-13</u>
2. Property Controlling in Section	S _____ T _____ R _____	_____
3. Miscellaneous Property in Sec.	S _____ T _____ R _____	_____
4. Lot No. _____, Recorded Plat _____		
5. Private Claims _____		

	A	B	C	D	E	F	G	H	I	J	K	L	M
2	6	5	4	3	2	1							
3													
4	7	8	9	10	11	12							
5													
6	18	17	16	15	14	13							
7													
8	19	20	21	22	23	24							
9													
10	30	29	28	27	26	25							
11													
12	31	32	33	34	35	36							
13													

I, Michael J. Rossow, in a field survey on April 08, 1997, do hereby certify that under requirements of P.A. 74, Michigan P.A. of 1970, the corner points mentioned in lines 1 and 2 above were in conformance with regulations and rules therefore as required in the current manual of survey instructions of the United States Department of the Interior, Bureau of Land Management or by a decree of a Court of Law and/or that the corner points mentioned in lines 3, 4 and 5 above were in conformance with the rules of the Michigan Board of Land Surveyors or by a Decree of a Court of Law; established, re-established, monumented, re-monumented, recovered, found as expressed below:

NOTE: Not more than 1 CORNER, may be recorded on this certificate.

A. Description of original monument and accessories and/or subsequent restoration:

A POST WAS SET FOR THIS CORNER IN ORIGINAL GOVERNMENT SURVEY (1817) WITH 2 WITNESSES 6" MAPLE N.66°E. 12 LINKS; 8" WHITE OAK, S.26°E. 9 LINKS BOTH OF WHICH ARE GONE. THE OLD ST. CLAIR COUNTY SURVEYOR'S RECORD INDICATES A "3/4" PIPE OVER A BUGGY AXLE", WAS WITNESSED AS CORNER IN 1942. ACT 74 CERTS. FILED IN L.3,P.280, L.6,P.68 & L.6,P.136 ALL IDENTIFY AND WITNESS A 1/2" REROD WITH COMMON WITNESSES TO ONE CORNER AT INTERSECTION OF BURNS & YAGER ROADS.

B. Description of corner evidence found and/or method applied in restoring or reestablishing corner:


FOUND 1/2" REROD. PER OLD ST CLAIR COUNTY SURVEYOR'S RECORD WITNESS: SOUTH TO SPIKE IN 18" OAK - 48.1' VERIFIED. ACT 74 CERT. L.3,P.280: SPIKE IN 30" OAK SOUTH 47.72'; VERIFIED. 5/8" IRON BAR EAST - 29.60'; VERIFIED. ACT 74 CERT. L.6,P.136: E.29.60' TO 5/8" IRON (N.1/4 COR. ST. CLAIR TWP.); VERIFIED. S.W. 60.54' TO SP. IN (N. D.E.P.); VERIFIED, 60.39' MEASURED. ACT 74 CERT. L.6,P.68: 48.15' S. TO DOUBLE HEAD NAIL IN E. SIDE 36" OAK TREE; VERIFIED. 60.53' SW TO SPIKE IN N. SIDE POWER POLE: VERIFIED. 70.54' ESE TO DOUBLE HEAD NAIL IN 10" ELM TREE: VERIFIED. CORNER VERIFIED WITH ACT 132 SURVEYS L.6,P.124, L.14,P.152, L.14,P.45 & L.14,P.150.

PA 345-1990
PEER COMMITTEE

APPROVED 7-11-97

C. Description of monument for corner and accessories established to perpetuate locating the position of the corner:

SET A 2" DIA. ALUMINUM CAP WITH MAGNET ATTACHED & INSCRIBED "ST. CLAIR COUNTY OFFICIAL CORNER" ON THE EXISTING 1/2" REROD.
S.87°10'36"W. 2649.13' TO S.W. COR. SEC. 31, STATE PLANE COORDINATES
N.86°43'25"E. 2620.50' TO S.E. COR. SEC. 31, STATE PLANE COORDINATES
EAST 29.63' TO N.1/4 CORNER SEC. 6, T.5N., R.16E
SOUTH 48.00' PK AND COUNTY TAG IN 36" OAK
S.W. 60.39' PK AND COUNTY TAG IN P. POLE
N.W. 180.38' PK AND COUNTY TAG IN P. POLE
N.E. 133.88' PK AND COUNTY TAG IN 10" ELM

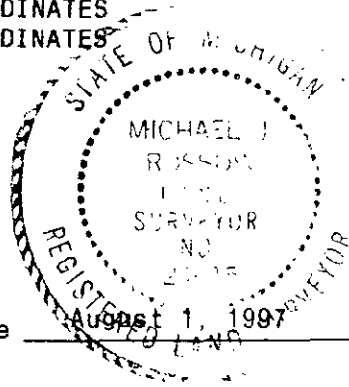

Signed by [Signature] Michael J. Rossow Date August 1, 1997

Surveyor's Michigan License No. 24615