

RECEIVED
 1994 SEP 20 PM 2:23
 DEPT. OF LAND SURVEYS
 ST. CLAIR COUNTY

**ST. CLAIR COUNTY, MICHIGAN
 OFFICIAL GOVERNMENT CORNER**



LAND CORNER RECORDATION CERTIFICATE
 Filing Requirement of Act 74, Mich. P.A. 1970

| | | |
|------------------------------------|--------------------------|---------------|
| | Located In: | Corner Code # |
| | Kimball Township | |
| 1. Public Land Survey | T <u>6N</u> R <u>16E</u> | <u>E-1</u> |
| | T _____ R _____ | _____ |
| | T _____ R _____ | _____ |
| | T _____ R _____ | _____ |
| 2. Property Controlling in Section | S _____ T _____ R _____ | <u>Sec-1</u> |
| | S _____ T _____ R _____ | _____ |
| 3. Miscellaneous Property in Sec. | S _____ T _____ R _____ | _____ |
| | S _____ T _____ R _____ | _____ |

Register of Deeds Stamp & File Number

4. Lot No. _____, Recorded Plat _____
 5. Private Claims _____

| | | | | | | | | | | | | | |
|----|----|----|----|----|----|----|---|---|---|---|---|---|---|
| | A | B | C | D | E | F | G | H | I | J | K | L | M |
| 2 | 6 | 5 | 4 | 3 | 2 | 1 | | | | | | | |
| 3 | | | | | | | | | | | | | |
| 4 | 7 | 8 | 9 | 10 | 11 | 12 | | | | | | | |
| 5 | | | | | | | | | | | | | |
| 6 | 18 | 17 | 16 | 15 | 14 | 13 | | | | | | | |
| 7 | | | | | | | | | | | | | |
| 8 | 19 | 20 | 21 | 22 | 23 | 24 | | | | | | | |
| 9 | | | | | | | | | | | | | |
| 10 | 30 | 29 | 28 | 27 | 26 | 25 | | | | | | | |
| 11 | | | | | | | | | | | | | |
| 12 | 31 | 32 | 33 | 34 | 35 | 36 | | | | | | | |
| 13 | | | | | | | | | | | | | |

I, John C. Niederhauser, in a field survey on March 15, 19 94, do hereby certify that under requirements of P.A. 74, Michigan P.A. of 1970, the corner points mentioned in lines 1 and 2 above were in conformance with regulations and rules therefore as required in the current manual of survey instructions of the United States Department of the Interior, Bureau of Land Management or by a decree of a Court of Law and/or that the corner points mentioned in lines 3, 4 and 5 above were in conformance with the rules of the Michigan Board of Land Surveyors or by a Decree of a Court of Law; established, re-established, monumented, re-monumented, recovered, found as expressed below:

NOTE: Not more than 1 corner, may be recorded on this certificate.

A. Description of original monument and accessories and/or subsequent restoration:

6" beech tree used as corner by William Preston in 1817. Monument box on centerline of pavement listed on Old County Surveyor's Record, St. Clair County. Corner recovered and recorded by G. James, Liber 1, page 933; monument box nearly on centerline pavement listed. Corner re-recorded by B. Collins, Liber 4, page 333, monument box listed.

STATE PLAIN COORDINATES

N. _____

E. _____

ELEVATION _____

B. Description of corner evidence found and/or method applied in restoring or reestablishing corner:

Found 1" iron rod in monument box on existing centerlines of Lapeer Road and Borth Road pavement. Verified corner from previously recorded witnesses and from old Michigan Department of Transportation road plans. Referenced recorded survey by B. Kreger, Liber 8, page 146 and unrecorded surveys by L. Dunn, B. Collins, G. James, B. Kreger, C. McDaniel, and John Niederhauser.


C. Description of monument for corner and accessories established to perpetuate locating the position of the corner:

1" iron rod in monument box on existing centerlines of Lapeer Road and Barth Road pavement. Located 0.45 feet south of the true Township line.

**N 45°E 71.05' to set P.K. nail with county remon tag in N.W. side power pole
 N 42°W 81.16' to set P.K. nail with county remon tag in S.W. side 18" box elder tree
 S 40°W 94.75' to set P.K. nail with county remon tag in N.W. side 8" box elder tree
 S 47°E 71.75' to set P.K. nail with county remon tag in N.E. side power pole
 WEST 2693.66' to N 1/4 corner of Section 5, T6N-R16E
 EAST 2673.59' to N 1/4 corner of Section 4, T6N-R16E**

Signed by John C. Niederhauser
 John C. Niederhauser
 Surveyor's Michigan License No. 24608

PA 345-1990 Date May 17, 1994
 PEER COMMITTEE
 APPROVED 6-17-94

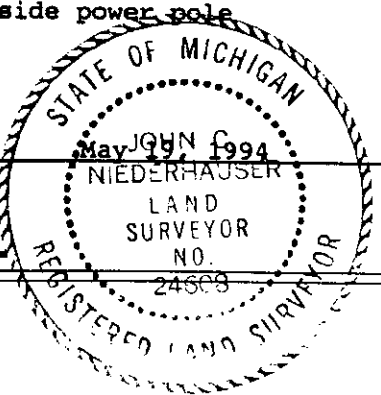

APPROVED AS AN OFFICIAL GOVERNMENT CORNER BY ST. CLAIR COUNTY:

Signed By: _____
 St. Clair County Land Surveyor

Date

Surveyor's Michigan License No. _____