

# ST. CLAIR COUNTY, MICHIGAN OFFICIAL GOVERNMENT CORNER



## LAND CORNER RECORDATION CERTIFICATE Filing Requirement of Act 74, Mich. P.A. 1970

Located In: \_\_\_\_\_ Corner Code # \_\_\_\_\_

Kimball Twp.

- |                                    |   |     |   |      |     |               |
|------------------------------------|---|-----|---|------|-----|---------------|
| 1. Public Land Survey              | T | 6N. | R | 16E. | E-1 |               |
|                                    | T |     | R |      |     |               |
|                                    | T |     | R |      |     |               |
|                                    | T |     | R |      |     |               |
| 2. Property Controlling in Section | S | T   | R |      |     | <i>Sec. 2</i> |
|                                    | S | T   | R |      |     |               |
|                                    | S | T   | R |      |     |               |
| 3. Miscellaneous Property in Sec.  | S | T   | R |      |     |               |
|                                    | S | T   | R |      |     |               |
4. Lot No. \_\_\_\_\_, Recorded Plat \_\_\_\_\_
5. Private Claims \_\_\_\_\_

RECEIVED  
REGISTER OF DEEDS  
ST. CLAIR COUNTY  
1995 AUG -4 AM 10:17  
Register of Deeds Stamp & File Number

**Daniel E. Johnson**                      **June 24,**                      **95**

I, \_\_\_\_\_, in a field survey on \_\_\_\_\_, 19\_\_\_\_, do hereby certify that under requirements of P.A. 74, Michigan P.A. of 1970, the corner points mentioned in lines 1 and 2 above were in conformance with regulations and rules therefore as required in the current manual of survey instructions of the United States Department of the Interior, Bureau of Land Management or by a decree of a Court of Law and/or that the corner points mentioned in lines 3, 4 and 5 above were in conformance with the rules of the Michigan Board of Land Surveyors or by a Decree of a Court of Law; established, re-established, monumented, re-monumented, recovered, found as expressed below:

**NOTE: Not more than 1 corner, may be recorded on this certificate.**

	A	B	C	D	E	F	G	H	I	J	K	L	M
2	6		5		4		3		2		1		
3													
4	7		8		9		10		11		12		
5													
7													
8	19		20		21		22		23		24		
9													
10	30		29		28		27		26		25		
11													
12	31		32		33		34		35		36		
13													

A. Description of original monument and accessories and/or subsequent restoration:

LIBER 007 PAGE 359

STATE PLAIN COORDINATES


N. \_\_\_\_\_

E. \_\_\_\_\_

B. Description of corner evidence found and/or method applied in restoring or reestablishing corner:

LIBER 007 PAGE 359

ELEVATION \_\_\_\_\_

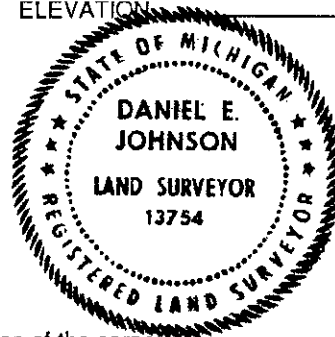

C. Description of monument for corner and accessories established to perpetuate locating the position of the corner:  
 Set 2" dia. aluminum cap inscribed "St. Clair County Official Corner" with magnet. (In monument box) *on a*  
 1" iron rod in monument box on existing centerlines of Lapeer Rd. & Barth Rd. pavement. Located 0.45' south of the true Township line.  
 N 45°E 71.05' to set PK nail w/county remon tag in NW side power pole  
 N 42°W 81.16' to set PK nail w/county remon tag in SW side 18" Box Elder Tree  
 S 40°W 94.75' to set PK nail w/county remon tag in NW side of 8" Box Elder Tree  
 S 47°E 71.75' to set PK nail w/county remon tag in NE side power pole  
 WEST 2693.66' to N 1/4 corner of Section 5, T6N-R16E  
 EAST 2673.59' to N 1/4 corner of Section 4, T6N-R16E

Signed by \_\_\_\_\_ *Daniel E. Johnson* \_\_\_\_\_ Date June 24, 1995  
 Daniel E. Johnson  
 Surveyor's Michigan License No. 13754

PA 345-1990  
PEER COMMITTEE

APPROVED AS AN OFFICIAL GOVERNMENT CORNER BY ST. CLAIR COUNTY:

Signed By: \_\_\_\_\_ *Daniel E. Johnson* \_\_\_\_\_  
 Daniel E. Johnson  
 Surveyor's Michigan License No. 13754

APPROVED 6-17-94  
 7-31-95  
 Date  
 LIBER 008 PAGE 124

Surveyor's Michigan License No. \_\_\_\_\_