

ST. CLAIR COUNTY, MICHIGAN OFFICIAL GOVERNMENT CORNER



DEC 02 1997

COMMISSION

LAND CORNER RECORDATION CERTIFICATE Filing Requirement of Act 74, Mich. P.A. 1970

	Located In:	Corner Code #
1. Public Land Survey	KIMBALL TWP. T 6N R 16E	E-13
2. Property Controlling in Section	S T R	
3. Miscellaneous Property in Sec.	S T R	

RECEIVED REGISTER OF DEEDS ST. CLAIR COUNTY 1997 AUG 21 AM 7:25

Register of Deeds Stamp & File Number

4. Lot No. _____, Recorded Plat _____
5. Private Claims _____

I, Michael J. Rossow, in a field survey on June 9 1997, do hereby certify that under requirements of P.A. 74, Michigan P.A. of 1970, the corner points mentioned in lines 1 and 2 above were in conformance with regulations and rules therefore as required in the current manual of survey instructions of the United States Department of the Interior, Bureau of Land Management or by a decree of a Court of Law and/or that the corner points mentioned in lines 3, 4 and 5 above were in conformance with the rules of the Michigan Board of Land Surveyors or by a Decree of a Court of Law; established, re-established, monumented, re-monumented, recovered, found as expressed below:

	A	B	C	D	E	F	G	H	I	J	K	L	M
2	6	5	4	3	2	1							
3													
4	7	8	9	10	11	12							
5													
6	18	17	16	15	14	13							
7													
8	19	20	21	22	23	24							
9													
10	30	29	28	27	26	25							
11													
12	31	32	33	34	35	36							
13													

NOTE: Not more than 1 CORNER, may be recorded on this certificate.

A. Description of original monument and accessories and/or subsequent restoration: A POST WAS SET AS THIS CORNER IN ORIGINAL GOVERNMENT SURVEY (1817) WITH 2 BEARING TREES WITNESSES: AN 18" ASH N.26°E. 17 LINKS AND A 18" BIRCH, S.60°W. 12 LINKS, BOTH OF WHICH WERE DESTROYED. THE OLD ST. CLAIR COUNTY SURVEYOR'S RECORD SHOWS NO RECORD OF THIS CORNER (1942). AN ACT 74 CERTIFICATE L.7,P.222 RECORDS A 1/2" REROD (1994) BUT INADVERTENTLY STATES IT IS SITUATED IN T.5N., R.16E. ST. CLAIR TWP. TRV SURVEY UNRECORDED OF 6-18-93 FOUND THIS IRON WITH A G. JAMES IDENTIFIER NUMBER. G.E. JAMES SURVEY UNRECORDED 6-05-90 IDENTIFIES A 1/2" REROD AS THIS CORNER. ST. CLAIR COUNTY ROAD COMMISSION TIES 11-06-87; BOOK #1202 IDENTIFIES A #19835 IRON.


B. Description of corner evidence found and/or method applied in restoring or reestablishing corner:

FOUND 1/2" REROD PER ACT 132 CERT. OF G.E. JAMES (UNRECORDED) OF 6-05-90 44.75' N.W. CENTERLINE CLF. POST: VERIFIED 46.67', MEASURED 30.83' N. SP. F.P.: DESTROYED 64.0' E.S.E. SP. 12" ELM: VERIFIED, SPIKE NOW GROWN OVER.

PA 345-1990 PEER COMMITTEE APPROVED 7-11-97 DEY

C. Description of monument for corner and accessories established to perpetuate locating the position of the corner:

SET A 2" DIA. ALUMINUM CAP WITH MAGNET ATTACHED & INSCRIBED "ST. CLAIR COUNTY OFFICIAL CORNER" ON THE EXISTING 1/2" REROD. S.86°38'37"W. 2718.56' TO SOUTH 1/4 COR. SEC. 32, STATE PLANE COORDINATES N.86°29'57"E. 2666.90' TO SOUTH 1/4 COR. SEC. 33, STATE PLANE COORDINATES 129.66' EAST TO THE N.W. CORNER OF SEC. 4, T.5N., R.16E. ESE 63.67' PK AND COUNTY TAG IN 15" ELM S. 24.86' PK AND COUNTY TAG IN 8" ASH ABOVE D.H. NAIL ENE 45.89' PK AND COUNTY TAG IN TWIN 6" APPLE ABOVE D.H. NAIL NNW 124.30' PK AND COUNTY TAG IN 10" ELM

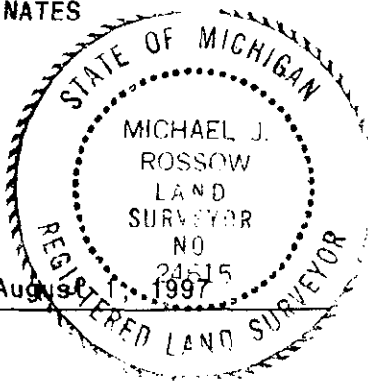

Signed by [Signature] Michael J. Rossow Date August 1, 1997
Surveyor's Michigan License No. 24615