

RECEIVED
 SEP 20 AM 2:23
 REGISTER OF DEEDS
 ST. CLAIR COUNTY

ST. CLAIR COUNTY, MICHIGAN
OFFICIAL GOVERNMENT CORNER
 LAND CORNER RECORDATION CERTIFICATE
 Filing Requirement of Act 74, Mich. P.A. 1970



Located In: Kimball Township Corner Code # F-1

1. Public Land Survey T 6N R 16E _____
 T _____ R _____
 T _____ R _____
 T _____ R _____

2. Property Controlling S _____ T _____ R _____
 in Section S _____ T _____ R _____

3. Miscellaneous S _____ T _____ R _____
 Property in Sec. S _____ T _____ R _____

4. Lot No. _____, Recorded Plat _____

5. Private Claims _____

Seg. 1

Register of Deeds Stamp & File Number

I, John C. Niederhauser, in a field survey on March 15, 19 94, do hereby certify that under requirements of P.A. 74, Michigan P.A. of 1970, the corner points mentioned in lines 1 and 2 above were in conformance with regulations and rules therefore as required in the current manual of survey instructions of the United States Department of the Interior, Bureau of Land Management or by a decree of a Court of Law and/or that the corner points mentioned in lines 3, 4 and 5 above were in conformance with the rules of the Michigan Board of Land Surveyors or by a Decree of a Court of Law; established, re-established, monumented, re-monumented, recovered, found as expressed below:

A	B	C	D	E	F	G	H	I	J	K	L
2	6	5	4	3	2	1					
3											
4	7	8	9	10	11	12					
5											
6	18	17	16	15	14	13					
7											
8	19	20	21	22	23	24					
9											
10	30	29	28	27	26	25					
11											
12	31	32	33	34	35	36					

NOTE: Not more than 1 corner, may be recorded on this certificate.

A. Description of original monument and accessories and/or subsequent restoration:

This corner was not set during original Government Survey, monument box listed on Old Surveyor's Record, St. Clair County. Corner recovered and recorded by C. Alloway, Liber 3, page 35, 3/4" square rod in monument box listed. St. Clair County Road Commission corner book, page 128, 3/4" square rod in monument box listed.

STATE PLAIN COORDINATES

N. _____

E. _____

ELEVATION _____

B. Description of corner evidence found and/or method applied in restoring or reestablishing corner:


Found 3/4" square iron rod in monument box on existing centerline of Lapeer Road pavement. Verified corner from previously recorded witnesses and from old Michigan Department of Transportation road plans. Also referenced unrecorded survey of G. James.

C. Description of monument for corner and accessories established to perpetuate locating the position of the corner:

3/4" square iron rod in monument box on existing centerline of Lapeer Road pavement. Located 0.17 feet south of the true Township line.
 SOUTH 50.28' to set P.K. nail with county remon tag in E. side of fence post
 S 65°E 111.29' to set P.K. nail with county remon tag in N.E. side power pole
 N 65°E 89.25' to set P.K. nail with county remon tag in S.E. side 15" maple tree
 N 60°W 95.38' to set P.K. nail with county remon tag in S.W. side of telephone pole
 WEST 2673.59' to N.W. corner of Section 4, T6N-R16E
 EAST 2681.34' to N.E. corner of Section 4, T6N-R16E

Signed by John C. Niederhauser
 Surveyor's Michigan License No. 24608

PA 345-1990 Date _____
 PEER COMMITTEE
 APPROVED 6-17-94

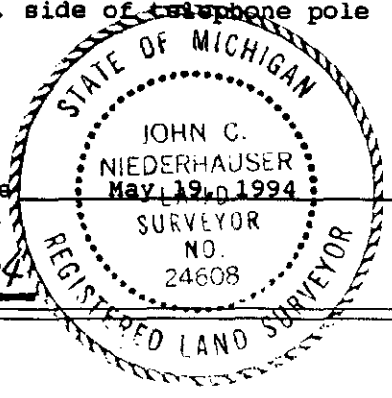

APPROVED AS AN OFFICIAL GOVERNMENT CORNER BY ST. CLAIR COUNTY:

Signed By: _____
 St. Clair County Land Surveyor

Date _____
 FILED 007 DATE 358

Surveyor's Michigan License No. _____