# ST. CLAIR COUNTY, MICHIGAN
# OFFICIAL GOVERNMENT CORNER

**LAND CORNER RECORDATION CERTIFICATE**
**Filing Requirement of Act 74, Mich. P.A. 1970**

| | | Located In: | Corner Code # |
|---|---|---|---|
| 1. Public Land Survey | | Kimball Twp. T 6N. R 16E. | F-1 |
| | | T ____ R ____ | |
| | | T ____ R ____ | |
| | | T ____ R ____ | |
| 2. Property Controlling | S ____ | T ____ R ____ | Seg 2 |
| in Section | S ____ | T ____ R ____ | |
| 3. Miscellaneous | S ____ | T ____ R ____ | |
| Property in Sec. | S ____ | T ____ R ____ | |

RECEIVED
1995 AUG -4 AM 10: 1
REGISTER OF DEEDS
ST. CLAIR COUNTY

Register of Deeds Stamp & File Number

4. Lot No. _____ , Recorded Plat _____
5. Private Claims _____

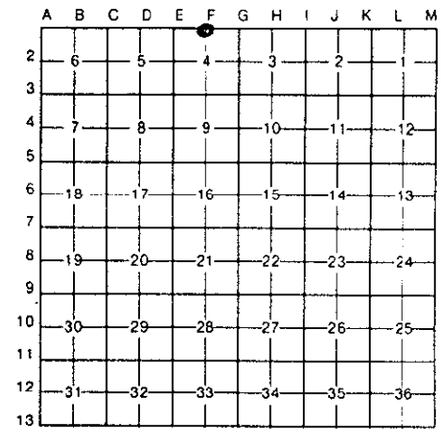


I, Daniel E. Johnson, in a field survey on June 24, 19 95, do hereby certify that under requirements of P.A. 74, Michigan P.A. of 1970, the corner points mentioned in lines 1 and 2 above were in conformance with regulations and rules therefore as required in the current manual of survey instructions of the United States Department of the Interior, Bureau of Land Management or by a decree of a Court of Law and/or that the corner points mentioned in lines 3, 4 and 5 above were in conformance with the rules of the Michigan Board of Land Surveyors or by a Decree of a Court of Law; established, re-established, monumented, re-monumented, recovered, found as expressed below:

**NOTE: Not more than 1 corner, may be recorded on this certificate.**

A. Description of original monument and accessories and/or subsequent restoration:

LIBER 007 PAGE 358

**STATE PLAIN COORDINATES**

N. _____

E. _____

ELEVATION _____

B. Description of corner evidence found and/or method applied in restoring or reestablishing corner:

LIBER 007 PAGE 358

STATE OF MICHIGAN
DANIEL E. JOHNSON
LAND SURVEYOR
13754
REGISTERED LAND SURVEYOR

C. Description of monument for corner and accessories established to perpetuate locating the position of the corner:
Set 2" dia. aluminum cap inscribed "St. Clair County Official Corner" with magnet. (In Monument Box) on a
3/4" square iron rod in monument box on exist. centerline of Lapeer Rd. Pvmt. Located 0.17' south of the true Township line.
SOUTH 50.28' to set PK w/county remon tag in E side of fence post
S 65°E 111.29' to set PK nail w/county remon tag in NE side power pole
N 65°E 89.25' to set PK nail w/county remon tag in SE side of 15" Maple Tree
N 60°W 95.38' to set PK nail w/county remon tag in SW side telephone pole
WEST 2673.59' to NW corner of Section 4, T6N-R16E
EAST 2681.34' to NE corner of Section 4, T6N-R16E

Signed by Daniel E. Johnson Date June 24, 1995

Surveyor's Michigan License No. Daniel E. Johnson 13754

PA 345-1990
~~PEER COMMITTEE~~
APPROVED 6-17-94

APPROVED AS AN OFFICIAL GOVERNMENT CORNER BY ST. CLAIR COUNTY:

Signed By: Daniel E. Johnson : 7-31-95
St. Clair County Land Surveyor Date

Surveyor's Michigan License No. Daniel E. Johnson 13754