

RECEIVED
 1994 SEP 20 PM 2:23
 DEEDS
 COUNTY

**ST. CLAIR COUNTY, MICHIGAN
 OFFICIAL GOVERNMENT CORNER**



LAND CORNER RECORDATION CERTIFICATE
 Filing Requirement of Act 74, Mich. P.A. 1970

Located In: Kimball Township Corner Code # G-1

1. Public Land Survey	T <u>6N</u> R <u>16E</u>	<u>G-1</u>
	T _____ R _____	_____
	T _____ R _____	_____
	T _____ R _____	_____
2. Property Controlling in Section	S _____ T _____ R _____	<u>Sec. 1</u>
	S _____ T _____ R _____	_____
3. Miscellaneous Property in Sec.	S _____ T _____ R _____	_____
	S _____ T _____ R _____	_____

Register of Deeds Stamp & File Number

4. Lot No. _____, Recorded Plat _____
 5. Private Claims _____

A	B	C	D	E	F	G	H	I	J	K	L	M
2	6	5	4	3	2	1						
3												
4	7	8	9	10	11	12						
5												
6	18	17	16	15	14	13						
7												
8	19	20	21	22	23	24						
9												
10	30	29	28	27	26	25						
11												
12	31	32	33	34	35	36						
13												

I, John C. Niederhauser, in a field survey on March 15, 19 94, do hereby certify that under requirements of P.A. 74, Michigan P.A. of 1970, the corner points mentioned in lines 1 and 2 above were in conformance with regulations and rules therefore as required in the current manual of survey instructions of the United States Department of the Interior, Bureau of Land Management or by a decree of a Court of Law and/or that the corner points mentioned in lines 3, 4 and 5 above were in conformance with the rules of the Michigan Board of Land Surveyors or by a Decree of a Court of Law; established, re-established, monumented, re-monumented, recovered, found as expressed below:

NOTE: Not more than 1 corner, may be recorded on this certificate.

A. Description of original monument and accessories and/or subsequent restoration:

Wood post set by William Preston in 1817. Monument box with square bar listed on Old County Surveyor's Record, St. Clair County. Corner recovered and recorded by C. Alloway, Liber 3, page 17, 3/4" square rod in monument box listed. Corner re-recorded by L. Thomas, Liber 5, page 117; 3/4" iron in monument box listed.

STATE PLAIN COORDINATES

N. _____

E. _____

ELEVATION _____

B. Description of corner evidence found and/or method applied in restoring or reestablishing corner:


Found 3/4" square iron bar in monument box on centerline of existing Lapeer Road pavement, 11.6' west of centerline of Ditty Road. Verified corner from previously recorded witnesses and from old Michigan Department of Transportation road plans. Also referenced recorded survey by J. Lansky, Liber 9, page 445 and unrecorded surveys by W. Sodenberg, B. Collins, T. Leach, and V.T.A.

C. Description of monument for corner and accessories established to perpetuate locating the position of the corner:

3/4" square iron bar in monument box on existing centerline of Lapeer Road pavement. Located 0.51 feet north of the true Township line.
 EAST 11.6' to centerline of existing Ditty Road to south
 S 04°W 48.47' to set P.K. nail with county remon tag in W. side of power pole
 S 70°E 137.11' to set P.K. nail with county remon tag in N.E. side of power pole
 N 69°30'E 127.40' to set P.K. nail with county remon tag in S.E. side telephone pole
 N 60°W 89.97' to set P.K. nail with county remon tag in N.W. side telephone pole
 WEST 2681.34' to N 1/4 corner of Section 4, T6N-R16E
 EAST 2607.59' to N 1/4 corner of Section 3, T6N-R16E

Signed by John C. Niederhauser
 Surveyor's Michigan License No. 24608

PA 345-1990 Date _____
 PEER COMMITTEE
 APPROVED 6-17-94

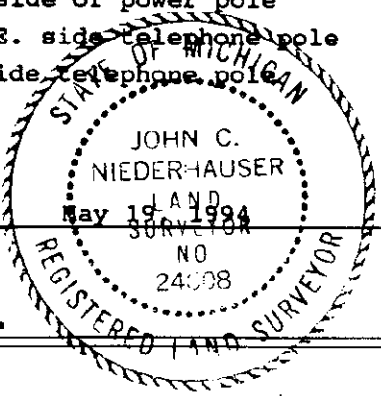

APPROVED AS AN OFFICIAL GOVERNMENT CORNER BY ST. CLAIR COUNTY:

Signed By: _____ Date _____

St. Clair County Land Surveyor

Date

Surveyor's Michigan License No.

LIBER 007 PAGE 357