

RECEIVED  
**ST. CLAIR COUNTY, MICHIGAN**  
**OFFICIAL GOVERNMENT CORNER**



SEP 20 1994

**LAND CORNER RECORDATION CERTIFICATE**  
 Filing Requirement of Act 74, Mich. P.A. 1970

	Located In:	Corner Code #
	<b>Kimball Township</b>	
1. Public Land Survey	T <u>6N</u> R <u>16E</u>	<u>H-1</u>
	T _____ R _____	_____
	T _____ R _____	_____
	T _____ R _____	_____
2. Property Controlling in Section	S _____ T _____ R _____	<u>Sec 1</u>
	S _____ T _____ R _____	_____
3. Miscellaneous Property in Sec.	S _____ T _____ R _____	_____
	S _____ T _____ R _____	_____

Register of Deeds Stamp & File Number

4. Lot No. \_\_\_\_\_, Recorded Plat \_\_\_\_\_  
 5. Private Claims \_\_\_\_\_

A	B	C	D	E	F	G	H	I	J	K	L	M
2	6	5	4	3	2	1						
3												
4	7	8	9	10	11	12						
5												
6	18	17	16	15	14	13						
7												
8	19	20	21	22	23	24						
9												
10	30	29	28	27	26	25						
11												
12	31	32	33	34	35	36						
13												

I, John C. Niederhauser, in a field survey on March 23, 19 94, do hereby certify that under requirements of P.A. 74, Michigan P.A. of 1970, the corner points mentioned in lines 1 and 2 above were in conformance with regulations and rules therefore as required in the current manual of survey instructions of the United States Department of the Interior, Bureau of Land Management or by a decree of a Court of Law and/or that the corner points mentioned in lines 3, 4 and 5 above were in conformance with the rules of the Michigan Board of Land Surveyors or by a Decree of a Court of Law; established, re-established, monumented, re-monumented, recovered, found as expressed below:

**NOTE: Not more than 1 corner, may be recorded on this certificate.**

A. Description of original monument and accessories and/or subsequent restoration:

This corner was not set during original Government survey. Nothing listed on Old Surveyor's Record, St. Clair County except witnesses. Corner recovered and recorded by L. Thomas, 3/4" pipe listed. Pinched top pipe listed on recorded survey by J. Lansky, Liber 9, page 445.

STATE PLAIN COORDINATES

N. \_\_\_\_\_

E. \_\_\_\_\_


ELEVATION \_\_\_\_\_

B. Description of corner evidence found and/or method applied in restoring or reestablishing corner:

Found 1" pinched iron pipe on old east and west fence line. Verified corner from previously recorded witnesses and recorded survey by J. Lansky, Liber 9, page 445 and by verbal statement given by Mr. Howard May who has lived in the area for many years. Also referenced unrecorded surveys by C. Alloway, and G. Whitmore.

C. Description of monument for corner and accessories established to perpetuate locating the position of the corner:

1" pinched iron pipe on old east and west fence line. Located 4.37 feet north of the true Township line.  
 N 45°E 7.33' to set P.K. nail with county remon tag in S.E. side 10" ash tree  
 S 20°E 19.70' to set P.K. nail with county remon tag in W. side 24" maple tree  
 WEST 2.02' to set P.K. nail with county remon tag in N. side R.R. tie fence  
 EAST 37.90' to set P.K. nail with county remon tag in S. side 8" maple tree  
 WEST 2607.59' to N.W. corner of Section 3, T6N-R16E  
 EAST 2710.13' to N.E. corner of Section 3, T6N-R16E

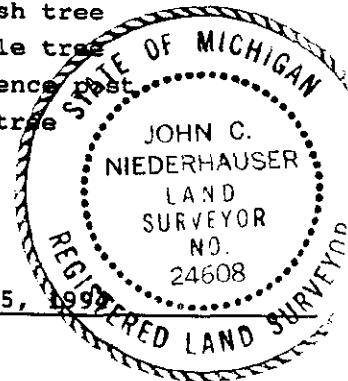

Signed by John C. Niederhauser  
 John C. Niederhauser  
 Surveyor's Michigan License No. 24608

PA 345-1990  
 PEER COMMITTEE  
 APPROVED 6-17-94

Date May 25, 1994

APPROVED AS AN OFFICIAL GOVERNMENT CORNER BY ST. CLAIR COUNTY:

Signed By: \_\_\_\_\_ Date \_\_\_\_\_  
 St. Clair County Land Surveyor

Surveyor's Michigan License No