

RECEIVED  
COUNTY CLERK

APR 20 AM 2:22

REGISTER OF DEEDS  
ST. CLAIR COUNTY

# ST. CLAIR COUNTY, MICHIGAN OFFICIAL GOVERNMENT CORNER



## LAND CORNER RECORDATION CERTIFICATE Filing Requirement of Act 74, Mich. P.A. 1970

Located In: Kimball Township Corner Code I-1

- |                                    |                          |              |
|------------------------------------|--------------------------|--------------|
| 1. Public Land Survey              | T <u>6N</u> R <u>16E</u> | <u>I-1</u>   |
|                                    | T _____ R _____          | _____        |
|                                    | T _____ R _____          | _____        |
|                                    | T _____ R _____          | _____        |
| 2. Property Controlling in Section | S _____ T _____ R _____  | <u>Sec 1</u> |
|                                    | S _____ T _____ R _____  | _____        |
| 3. Miscellaneous Property in Sec.  | S _____ T _____ R _____  | _____        |
|                                    | S _____ T _____ R _____  | _____        |

Register of Deeds Stamp & File Number

4. Lot No. \_\_\_\_\_, Recorded Plat \_\_\_\_\_
5. Private Claims \_\_\_\_\_

	A	B	C	D	E	F	G	H	I	J	K	L
2	6	5	4	3	2	1						
3												
4	7	8	9	10	11	12						
5												
6	18	17	16	15	14	13						
7												
8	19	20	21	22	23	24						
9												
10	30	29	28	27	26	25						
11												
12	31	32	33	34	35	36						
13												

I, John C. Niederhauser, in a field survey on March 23, 19 94, do hereby certify that under requirements of P.A. 74, Michigan P.A. of 1970, the corner points mentioned in lines 1 and 2 above were in conformance with regulations and rules therefore as required in the current manual of survey instructions of the United States Department of the Interior, Bureau of Land Management or by a decree of a Court of Law and/or that the corner points mentioned in lines 3, 4 and 5 above were in conformance with the rules of the Michigan Board of Land Surveyors or by a Decree of a Court of Law; established, re-established, monumented, re-monumented, recovered, found as expressed below:

**NOTE: Not more than 1 corner, may be recorded on this certificate.**

**A. Description of original monument and accessories and/or subsequent restoration:**

Wood post set by William Preston 1817.  
No other records were found for this corner.

STATE PLAIN COORDINATES

N. \_\_\_\_\_

E. \_\_\_\_\_

ELEVATION \_\_\_\_\_


**B. Description of corner evidence found and/or method applied in restoring or reestablishing corner:**

Nothing was found for corner position and no occupation exists in general area of corner. Set corner by extending a straight line north from the 1/4 corner common to Sections 2 and 3, T6N-R16E and the corner common to Sections 2, 3, 10 and 11 and intersecting the township line.

**C. Description of monument for corner and accessories established to perpetuate locating the position of the corner:**

Capped 1/2" rerod #24608. Located on the True Township line.

N.N.E. 104.17' to set P.K. nail with county remon tag in S.E. side 6" elm tree  
WEST 119.00' to set P.K. nail with county remon tag in N. side 5" poplar tree  
N.E. 151.05' to set P.K. nail with county remon tag in N.W. side 10" elm tree  
SOUTH 539' to north bank of Black River  
WEST 2710.13' to N 1/4 corner of Section 3, T6N-R16E  
EAST 2702.67' to N 1/4 corner of Section 2, T6N-R16E  
SOUTH 2868.28' to 1/4 corner common to Sections 2 & 3, T6N-R16E

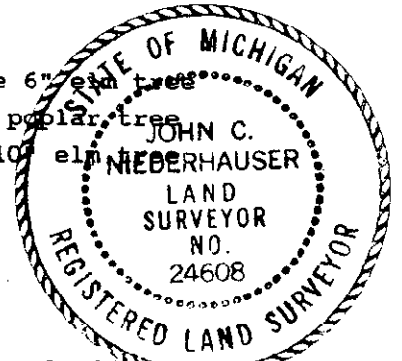

Signed by John C. Niederhauser PA 345-1990 Date July 28, 1994

Surveyor's Michigan License No. 24608 PEER COMMITTEE

APPROVED 6-24-94

APPROVED AS AN OFFICIAL GOVERNMENT CORNER BY ST. CLAIR COUNTY:

Signed By: \_\_\_\_\_ Date \_\_\_\_\_

St. Clair County Land Surveyor

Date

Surveyor's Michigan License No. \_\_\_\_\_