

RECEIVED
SEP 20 1994

ST. CLAIR COUNTY, MICHIGAN OFFICIAL GOVERNMENT CORNER



1994 SEP 20 PM 2:22

REGISTER OF DEEDS
ST. CLAIR COUNTY

LAND CORNER RECORDATION CERTIFICATE
Filing Requirement of Act 74, Mich. P.A. 1970

	Located In:	Corner Code #
	Kimball Township	
1. Public Land Survey	T <u>6N</u> R <u>16E</u>	<u>J-1</u>
	T _____ R _____	_____
	T _____ R _____	_____
	T _____ R _____	_____
2. Property Controlling in Section	S _____ T _____ R _____	<u>Sec. 1</u>
	S _____ T _____ R _____	_____
3. Miscellaneous Property in Sec.	S _____ T _____ R _____	_____
	S _____ T _____ R _____	_____

Register of Deeds Stamp & File Number

4. Lot No. _____, Recorded Plat _____
5. Private Claims _____

A	B	C	D	E	F	G	H	I	J	K	L	M
2	5	5	4	3	2							
3												
4	7	8	9	10	11	12						
5												
6	18	17	16	15	14	13						
7												
8	19	20	21	22	23	24						
9												
10	30	29	28	27	26	25						
11												
12	31	32	33	34	35	36						
13												

I, John C. Niederhauser, in a field survey on March 23, 19 94, do hereby certify that under requirements of P.A. 74, Michigan P.A. of 1970, the corner points mentioned in lines 1 and 2 above were in conformance with regulations and rules therefore as required in the current manual of survey instructions of the United States Department of the Interior, Bureau of Land Management or by a decree of a Court of Law and/or that the corner points mentioned in lines 3, 4 and 5 above were in conformance with the rules of the Michigan Board of Land Surveyors or by a Decree of a Court of Law; established, re-established, monumented, re-monumented, recovered, found as expressed below:

NOTE: Not more than 1 corner, may be recorded on this certificate.

A. Description of original monument and accessories and/or subsequent restoration:
This corner was not set during original government survey.
No other records were found for this corner.

STATE PLAIN COORDINATES

N. _____


E. _____

ELEVATION _____

B. Description of corner evidence found and/or method applied in restoring or reestablishing corner:
Nothing was found for corner position and no occupation exists in general area of corner. Set corner on a straight line between the N.W. corner of Section 2, T6N-R16E and the S.E. corner of Section 35, T7N-R16E and exactly half way between the N.W. corner and N.E. corner of Section 2, T7N-R16E. Set iron lies in Black River Flood Plain.

C. Description of monument for corner and accessories established to perpetuate locating the position of the corner:
Capped 1/2" rerod #24608. Located on the True Township line.

- N.N.E. 126.38' to top center of water well
- W.N.W. 160.75' to set P.K. nail with county remon tag in N.E. side 6" elm tree
- W. 11.84' to set P.K. nail with county remon tag in S. side bird feeder post
- E. 174.33' to set P.K. nail with county remon tag in N. side 6" elm tree
- WEST 2702.67 to N.W. corner of Section 2, T6N-R16E
- EAST 2702.67 to N.E. corner of Section 2, T6N-R16E

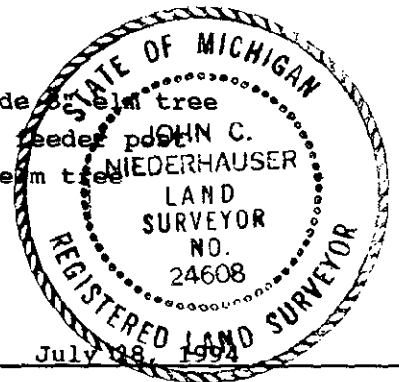

Signed by John C. Niederhauser PA 345-1990 Date July 28, 1994
Surveyor's Michigan License No. 24608 PEER COMMITTEE
APPROVED 6-24-94

APPROVED AS AN OFFICIAL GOVERNMENT CORNER BY ST. CLAIR COUNTY:

Signed By: _____
St. Clair County Land Surveyor

Surveyor's Michigan License No. _____

Date 007 FILE # 354