

ST. CLAIR COUNTY, MICHIGAN
OFFICIAL GOVERNMENT CORNER



DEC 0 2 1997

LAND CORNER RECORDATION CERTIFICATE
Filing Requirement of Act 74, Mich. P.A. 1970

COMMISSION

	Located In:	Corner Code #
	KIMBALL TWP.	
1. Public Land Survey	T <u>6N.</u> R <u>16E.</u>	<u>L-13</u>
	T _____ R _____	_____
2. Property Controlling in Section	S _____ T _____ R _____	_____
	S _____ T _____ R _____	_____
3. Miscellaneous Property in Sec.	S _____ T _____ R _____	_____
	S _____ T _____ R _____	_____
4. Lot No. _____, Recorded Plat _____		
5. Private Claims _____		

Register of Deeds Stamp & File Number

	A	B	C	D	E	F	G	H	I	J	K	L	M
2	6	5	4	3	2	1							
3													
4	7	8	9	10	11	12							
5													
6	18	17	16	15	14	13							
7													
8	19	20	21	22	23	24							
9													
10	30	29	28	27	26	25							
11													
12	31	32	33	34	35	36							
13													

I, Michael J. Rossow, in a field survey on May 12, 1997, do hereby certify that under requirements of P.A. 74, Michigan P.A. of 1970, the corner points mentioned in lines 1 and 2 above were in conformance with regulations and rules therefore as required in the current manual of survey instructions of the United States Department of the Interior, Bureau of Land Management or by a decree of a Court of Law and/or that the corner points mentioned in lines 3, 4 and 5 above were in conformance with the rules of the Michigan Board of Land Surveyors or by a Decree of a Court of Law; established, re-established, monumented, re-monumented, recovered, found as expressed below:

NOTE: Not more than 1 CORNER, may be recorded on this certificate.

A. Description of original monument and accessories and/or subsequent restoration:

A POST WAS SET FOR THIS CORNER IN ORIGINAL GOVERNMENT SURVEY WITH THE FOLLOWING BEARING TREES, 40" WHITE OAK S.74°W. 28 LINKS AND A 10" LYNN TREE N.85°W. 28 LINKS BOTH OF WHICH ARE GONE (1817)
THE OLD ST. CLAIR COUNTY SURVEYOR'S RECORD WITNESSES A "I" PIPE AS THE CORNER (1942) NO ACT 74 CERTIFICATES FILED FOR THIS CORNER. NO ACT 132 CERT MENTION THIS CORNER. THE "AIR INDUSTRIAL PARK PLAT" (L.89 PLATS PAGE 03) IN 1987 REFERENCES THIS CORNER. ST. CLAIR COUNTY ROAD COMMISSION ON 7-27-87 WITNESS THIS CORNER.

B. Description of corner evidence found and/or method applied in restoring or reestablishing corner:


FOUND A 1/2" REBAR 12.7' SOUTHEAST OF THE SOUTH EDGE OF GRATIOT ROAD. COMPARED DISTANCE SHOWN ON "AIR INDUSTRIAL PARK PLAT" OF 2679.79' WEST TO THE SOUTHWEST CORNER OF SEC. 36 T.6N., R.16E. TO BE 2679.63' MEASURED. OLD COUNTY SURVEYORS TIE "EAST 67.60' TO 1/4 POST OF SEC. 1 ST. CLAIR" MEASURES AS 67.5'
ST. CLAIR COUNTY ROAD COMMISSION WITNESSES OF 8-27-87:
111.30' N. TO MSHD TAG; VERIFIED
96.19' N.W. TO SCCRC TAG. DEP; VERIFIED
12.71' NWLY. TO S. EDGE PAVT; VERIFIED
75.95' WSW TO FACE 6" SIGN POST; VERIFIED
58.12 SSE LG. SP. SCCRC 12" ASH; VERIFIED

ACCEPTED AS TRUE CORNER

C. Description of monument for corner and accessories established to perpetuate locating the position of the corner:

SET A 2" DIA. ALUMINUM CAP WITH MAGNET ATTACHED & INSCRIBED "ST CLAIR COUNTY OFFICIAL CORNER" ON THE EXISTING 1/2" REBAR.
S.86°07'11"W. 2679.63' TO S.W. CORNER SECTION 36, STATE PLANE COORDINATES.
N.85°43'09"E. 2697.86' TO S.E. CORNER SECTION 36, STATE PLANE COORDINATES.
67.50' EAST TO THE N. 1/4 CORNER OF SEC. 1, T.5N., R.16E.
86.82' SSE TO P.K. IN CTY TAG IN 18" ASH
96.23' NW TO P.K. IN CTY TAG IN D.E.P.
111.58' N. TO P.K. IN CTY TAG IN D.E.P.
87.30' ESE TO P.K. IN CTY TAG IN 30" ASH

PA 345-1990
PEER COMMITTEE
APPROVED 7-18-97
D.E.Y.

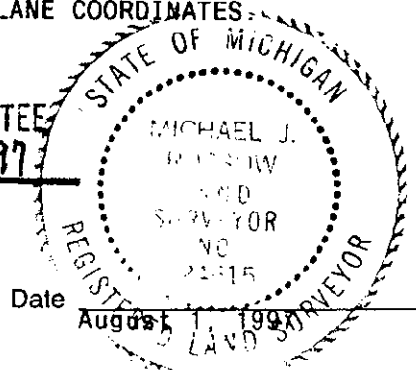

Signed by _____ Michael J. Rossow _____ Date _____

Surveyor's Michigan License No. _____ 24815 _____