

SUBMITTED
 REMONUM
 JUL 14 1996
 COMMISSION

ST. CLAIR COUNTY, MICHIGAN
 OFFICIAL GOVERNMENT CORNER



LAND CORNER RECORDATION CERTIFICATE
 Filing Requirement of Act 74, Mich. P.A. 1970

| | | |
|---------------------------------------|-------------------------|---------------|
| | Located In: | Corner Code # |
| | Kimball Township | |
| 1. Public Land Survey | T <u>6</u> R <u>16</u> | <u>M-11</u> |
| | T _____ R _____ | _____ |
| | T _____ R _____ | _____ |
| | T _____ R _____ | _____ |
| 2. Property Controlling in Section | S _____ T _____ R _____ | _____ |
| | S _____ T _____ R _____ | _____ |
| 3. Miscellaneous Property in Sec. | S _____ T _____ R _____ | _____ |
| | S _____ T _____ R _____ | _____ |
| 4. Lot No. _____, Recorded Plat _____ | | |
| 5. Private Claims _____ | | |

1996 JUL 31 AM 8:08
 RECEIVED
 MARYLN DUNN
 REGISTER OF DEEDS
 ST. CLAIR COUNTY
 Register of Deeds Stamp File Number

I, John C. Niederhauser, in a field survey on June 26, 1995, do hereby certify that under requirements of P.A. 74, Michigan P.A. of 1970, the corner points mentioned in lines 1 and 2 above were in conformance with regulations and rules therefore as required in the current manual of survey instructions of the United States Department of the Interior, Bureau of Land Management or by a decree of a Court of Law and/or that the corner points mentioned in lines 3, 4 and 5 above were in conformance with the rules of the Michigan Board of Land Surveyors or by a Decree of a Court of Law: established, re-established, monumented, re-monumented, recovered, found as expressed below:


| | | | | | | | | | | | | | |
|----|----|----|----|----|----|----|---|---|---|---|---|---|---|
| | A | B | C | D | E | F | G | H | I | J | K | L | M |
| 2 | 6 | 5 | 4 | 3 | 2 | 1 | | | | | | | |
| 3 | | | | | | | | | | | | | |
| 4 | 7 | 8 | 9 | 10 | 11 | 12 | | | | | | | |
| 5 | | | | | | | | | | | | | |
| 6 | 18 | 17 | 16 | 15 | 14 | 13 | | | | | | | |
| 7 | | | | | | | | | | | | | |
| 8 | 19 | 20 | 21 | 22 | 23 | 24 | | | | | | | |
| 9 | | | | | | | | | | | | | |
| 10 | 30 | 29 | 28 | 27 | 26 | 25 | | | | | | | |
| 11 | | | | | | | | | | | | | |
| 12 | 31 | 32 | 33 | 34 | 35 | 36 | | | | | | | |
| 13 | | | | | | | | | | | | | |

NOTE: Not more than 1 corner, may be recorded on this certificate.

A. Description of original monument and accessories and/or subsequent restoration:
 Original corner set on a 12" diameter White Ash tree by William Preston in 1817. Wood stake listed on Old County Surveyor's Record for St. Clair County. Corner recovered and recorded by C. Alloway Liber 3, Page 7; and by B. Collins Liber 4, Page 207. Corner listed on surveys by G. James dated 2-12-76 and by V.T.A. dated 11-23-73. Corner also listed on plats Liber 29, Page 4 and Liber 55, Page 29.

B. Description of corner evidence found and/or method applied in restoring or reestablishing corner:
 Found 3/8" iron rod in monument box at the intersection of Range Road and Smiths Creek Road to the west and Sixth Street to the east. Verified corner from previously recorded witnesses. Referenced surveys by G. James dated 2-12-76 and by V.T.A. dated 11-23-73. Also referenced subdivision plats Liber 29, Page 4 and Liber 55, Page 29. This corner is common to corner A-11 of T6N - R17E and can be referenced for additional information.

C. Description of monument for corner and accessories established to perpetuate locating the position of the corner:
 Set a 2" diameter aluminum cap with magnet, inscribed "St. Clair County Official Corner" on a 3/8" iron rod in monument box at the intersection of Range Road and Smiths Creek Road to the west and Sixth Street to the east. Located on the true Township line and is common to corner A-11 of T6N - R17E.
 N 40°W 77.52' to set P.K. nail with county remon tag in W. side of a power pole.
 S 45°W 65.88' to set P.K. nail with county remon tag in E. side of a power pole.
 S 45°E 61.07' to set P.K. nail with county remon tag in W. side of a power pole.
 N 35°E 73.75' to set P.K. nail with county remon tag in top of S. guard rail post.
 NORTH 2761.93' to corner M-10 of T6N - R16E.
 SOUTH 2703.94' to corner M-12 of T6N - R16E.
 SOUTH 1474.87' to found P.K. nail at centerline of 9th Street to the west.

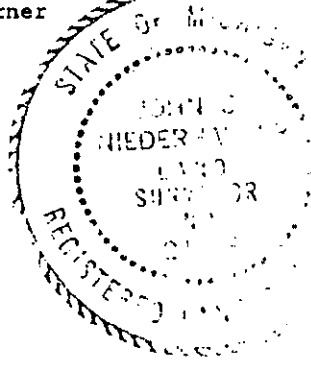

PA 345-1990
 PEER COMMITTEE
 APPROVED 7-21-95

Signed by [Signature] Date May 30, 1996

Surveyor's Michigan License No. 24608