

# ST. CLAIR COUNTY, MICHIGAN OFFICIAL GOVERNMENT CORNER



## LAND CORNER RECORDATION CERTIFICATE Filing Requirement of Act 74, Mich. P.A. 1970

Located In: \_\_\_\_\_ Corner Code # \_\_\_\_\_

- |                                    |   |                     |   |             |             |
|------------------------------------|---|---------------------|---|-------------|-------------|
| 1. Public Land Survey              |   | <b>Kimball Twp.</b> |   |             |             |
|                                    | T | <b>6N.</b>          | R | <b>16E.</b> | <b>-H-1</b> |
|                                    | T | _____               | R | _____       | _____       |
|                                    | T | _____               | R | _____       | _____       |
|                                    | T | _____               | R | _____       | _____       |
| 2. Property Controlling in Section | S | _____               | T | _____       | R           |
|                                    | S | _____               | T | _____       | R           |
| 3. Miscellaneous Property in Sec.  | S | _____               | T | _____       | R           |
|                                    | S | _____               | T | _____       | R           |

RECEIVED  
REGISTER OF DEEDS  
ST. CLAIR COUNTY  
1995 AUG -4 AM 10: 7  
Register of Deeds Stamp & File Number

4. Lot No. \_\_\_\_\_, Recorded Plat \_\_\_\_\_  
5. Private Claims \_\_\_\_\_

I, **Daniel E. Johnson**, in a field survey on **June 25, 1995**, do hereby certify that under requirements of P.A. 74, Michigan P.A. of 1970, the corner points mentioned in lines 1 and 2 above were in conformance with regulations and rules therefore as required in the current manual of survey instructions of the United States Department of the Interior, Bureau of Land Management or by a decree of a Court of Law and/or that the corner points mentioned in lines 3, 4 and 5 above were in conformance with the rules of the Michigan Board of Land Surveyors or by a Decree of a Court of Law; established, re-established, monumented, re-monumented, recovered, found as expressed below:

	A	B	C	D	E	F	G	H	I	J	K	L	M
2	6	5	4	3	2	1							
3													
4	7	8	9	10	11	12							
5													
6	18	17	16	15	14	13							
7													
8	19	20	21	22	23	24							
9													
10	30	29	28	27	26	25							
11													
12	31	32	33	34	35	36							
13													

**NOTE: Not more than 1 corner, may be recorded on this certificate.**

A. Description of original monument and accessories and/or subsequent restoration:

**LIBER 007 PAGE 356**

STATE PLAIN COORDINATES


N. \_\_\_\_\_

E. \_\_\_\_\_

ELEVATION \_\_\_\_\_

B. Description of corner evidence found and/or method applied in restoring or reestablishing corner:

**LIBER 007 PAGE 356**

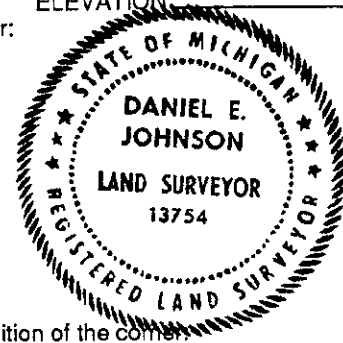

C. Description of monument for corner and accessories established to perpetuate locating the position of the corner:  
Set 2" dia. aluminum cap inscribed "St. Clair County Official Corner" with magnet on a 1" pinched iron pipe on old east and west fence line. Located 4.37' north of the true Township line.  
N 45°E 7.33' to set PK nail w/county remon tag in SE side 10" Ash Tree  
S 20°E 19.70' to set PK nail w/county remon tag in W. side 24" Maple Tree  
WEST 2.02' to set PK nail w/county remon tag in N side R.R. tie fence post  
EAST 37.90' to set PK nail w/county remon tag in S side 8" Maple Tree  
WEST 2607.59' to NW corner of Section 3, T6N-R16E  
EAST 2710.13' to NE corner of Section 3, T6N-R16E

Signed by Daniel E. Johnson Date June 25, 1995  
Daniel E. Johnson

Surveyor's Michigan License No. 13754

PA 345-1990  
PEER COMMITTEE

APPROVED AS AN OFFICIAL GOVERNMENT CORNER BY ST. CLAIR COUNTY:

Signed By: Daniel E. Johnson : 7-31-95  
St. Clair County Land Surveyor Daniel E. Johnson  
13754

APPROVED 6-17-94 *Dune*  
LIBER 008 PAGE 127

Surveyor's Michigan License No. \_\_\_\_\_