# ST. CLAIR COUNTY, MICHIGAN
# OFFICIAL GOVERNMENT CORNER

## LAND CORNER RECORDATION CERTIFICATE
**Filing Requirement of Act 74, Mich. P.A. 1970**

| | | Located In: | Corner Code #/ |
|---|---|---|---|
| 1. Public Land Survey | | Kimball Twp. T 6N. R 16E. | -D-1 |
| | | T ____ R ____ | |
| | | T ____ R ____ | |
| | | T ____ R ____ | |
| 2. Property Controlling | S ____ | T ____ R ____ | |
| in Section | S ____ | T ____ R ____ | Sec. 2 |
| 3. Miscellaneous | S ____ | T ____ R ____ | |
| Property in Sec. | S ____ | T ____ R ____ | |

RECEIVED
1995 AUG -4 AM 10: 17
REGISTER OF DEEDS
ST. CLAIR COUNTY

Register of Deeds Stamp & File Number

4. Lot No. _____ , Recorded Plat _____
5. Private Claims _____

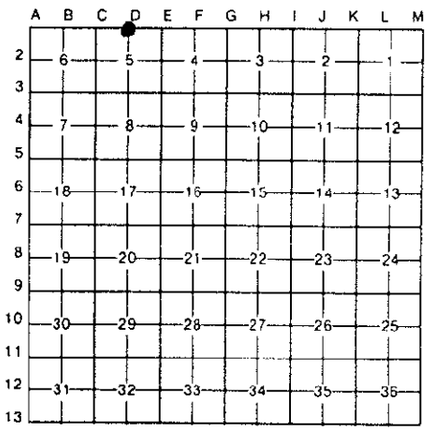


Daniel E. Johnson June 24, 95

I, _____ , in a field survey on _____ , 19 _____ , do hereby certify that under requirements of P.A. 74, Michigan P.A. of 1970, the corner points mentioned in lines 1 and 2 above were in conformance with regulations and rules therefore as required in the current manual of survey instructions of the United States Department of the Interior, Bureau of Land Management or by a decree of a Court of Law and/or that the corner points mentioned in lines 3, 4 and 5 above were in conformance with the rules of the Michigan Board of Land Surveyors or by a Decree of a Court of Law; established, re-established, monumented, re-monumented, recovered, found as expressed below:

**NOTE: Not more than 1 corner, may be recorded on this certificate.**

A. Description of original monument and accessories and/or subsequent restoration:

LIBER 007 PAGE 360

**STATE PLAIN COORDINATES**

N. _____

E. _____

ELEVATION _____

B. Description of corner evidence found and/or method applied in restoring or reestablishing corner:

LIBER 007 PAGE 360

STATE OF MICHIGAN
DANIEL E. JOHNSON
LAND SURVEYOR
13754
REGISTERED LAND SURVEYOR

C. Description of monument for corner and accessories established to perpetuate locating the position of the corner:

Set 2" dia. aluminum cap inscribed "St. Clair County Official Corner" with magnet. (In monument box) on a
1/2" rerod in monument box on existing centerline of Lapeer Rd. pavement in line with old fence to south. Located on the true Township line.
S 45°E 40.40' to set PK nail w/county remon tag in NE side 12" Ash Tree
SOUTH 40.00' to set PK nail w/county remon tag in W side power pole
N 16°W 77.45' to set PK nail w/county remon tag in E side of 8" Ash Tree
N 45°E 30.52' to set PK nail w/county remon tag in top of guard rail post
WEST 2660.28' to NW corner of Section 5, T6N-R16E
EAST 2693.66' to NE corner of Section 5, T6N-R16E

Signed by Daniel E. Johnson Date June 24, 1995
Daniel E. Johnson
Surveyor's Michigan License No. 13754

PA 345-1990
PEER COMMITTEE
APPROVED 6-17-94

APPROVED AS AN OFFICIAL GOVERNMENT CORNER BY ST. CLAIR COUNTY:

Signed By: Daniel E. Johnson : 7-31-95
St. Clair County Land Surveyor Date
Daniel E. Johnson
Surveyor's Michigan License No. 13754

LIBER 008 PAGE 123