

# ST. CLAIR COUNTY, MICHIGAN OFFICIAL GOVERNMENT CORNER



## LAND CORNER RECORDATION CERTIFICATE Filing Requirement of Act 74, Mich. P.A. 1970

Located In: \_\_\_\_\_ Corner Code ~~##~~ \_\_\_\_\_

Kimball Twp.

1. Public Land Survey	T	6N.	R	16E.	-B-1	
	T		R			
	T		R			
	T		R			
2. Property Controlling in Section	S		T		R	
	S		T		R	
3. Miscellaneous Property in Sec.	S		T		R	
	S		T		R	

RECEIVED  
 REGISTER OF DEEDS  
 ST. CLAIR COUNTY  
 1995 AUG -4 AM 10:17  
 Register of Deeds Stamp & File Number

4. Lot No. \_\_\_\_\_, Recorded Plat \_\_\_\_\_  
 5. Private Claims \_\_\_\_\_

I, Daniel E. Johnson, in a field survey on June 23, 1995  
 do hereby certify that under requirements of P.A. 74, Michigan P.A. of 1970, the corner points mentioned in lines 1 and 2 above were in conformance with regulations and rules therefore as required in the current manual of survey instructions of the United States Department of the Interior, Bureau of Land Management or by a decree of a Court of Law and/or that the corner points mentioned in lines 3, 4 and 5 above were in conformance with the rules of the Michigan Board of Land Surveyors or by a Decree of a Court of Law; established, re-established, monumented, re-monumented, recovered, found as expressed below:

	A	B	C	D	E	F	G	H	I	J	K	L	M
2	6	5	4	3	2	1							
3													
4	7	8	9	10	11	12							
5													
6	13	17	16	15	14	13							
7													
8	19	20	21	22	23	24							
9													
10	30	29	28	27	26	25							
11													
12	31	32	33	34	35	36							

**NOTE: Not more than 1 corner, may be recorded on this certificate.**

A. Description of original monument and accessories and/or subsequent restoration:

LIBER 007 PAGE 362


STATE PLAIN COORDINATES

N. \_\_\_\_\_

E. \_\_\_\_\_

B. Description of corner evidence found and/or method applied in restoring or reestablishing corner:

LIBER 007 PAGE 362

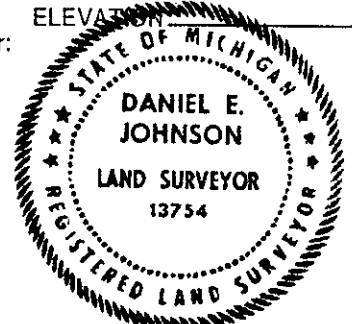

ELEVATION \_\_\_\_\_

C. Description of monument for corner and accessories established to perpetuate locating the position of the corner:  
 Set with 2" dia. aluminum cap inscribed "St. Clair County Official Corner" with magnet.  
 (In monument box) on a  
 Capped iron #19835 in monument box. Located 0.41' South of the true Township line old  
 S 30°E 28.80' to set PK nail w/county remon tag in top of guard rail post  
 S 30°W 62.25' to set PK nail w/county remon tag in SE side of bell riser pole  
 N 20°W 85.60' to set PK nail w/county remon tag in W side of twin 12" Elm Tree  
 N 20°E 83.90' to set PK nail w/county remon tag in E side of 8" Elm Tree  
 WEST 2685.56' to N.W. corner Section 6, T6N-R16E  
 EAST 2663.44' to N.E. corner Section 6, T6N-R16E  
 EAST 2660.28' to N 1/4 corner of Section 5, T6N-R16E

Signed by Daniel E. Johnson Date June 23, 1995  
 Daniel E. Johnson  
 13754

Surveyor's Michigan License No. \_\_\_\_\_

PA 345-1990  
 PEER COMMITTEE

APPROVED AS AN OFFICIAL GOVERNMENT CORNER BY ST. CLAIR COUNTY:  
 Signed By: Daniel E. Johnson : 7-31-95 Date 7-31-95

St. Clair County Land Surveyor Daniel E. Johnson  
 13754

Surveyor's Michigan License No. \_\_\_\_\_

Date  
 LIBER 008 PAGE 121