

# ST. CLAIR COUNTY, MICHIGAN OFFICIAL GOVERNMENT CORNER



## LAND CORNER RECORDATION CERTIFICATE Filing Requirement of Act 74, Mich. P.A. 1970

RECEIVED  
 REGISTER OF DEEDS  
 ST. CLAIR COUNTY  
 95 AUG -4 11:10:19

	Located In:	Corner Code #
	Kimball Twp.	
1. Public Land Survey	T <u>6N.</u> R <u>16E.</u>	<u>A-1</u>
	T _____ R _____	_____
	T _____ R _____	_____
	T _____ R _____	_____
2. Property Controlling in Section	S _____ T _____ R _____	<u>See</u>
	S _____ T _____ R _____	_____
3. Miscellaneous Property in Sec.	S _____ T _____ R _____	_____
	S _____ T _____ R _____	_____

Register of Deeds Stamp & File Number

4. Lot No. \_\_\_\_\_, Recorded Plat \_\_\_\_\_  
 5. Private Claims \_\_\_\_\_

	A	B	C	D	E	F	G	H	I	J	K	L	M
2	6		5		4		3		2		1		
3													
4	7		8		9		10		11		12		
5													
6	16		17		16		15		14		13		
7													
8	19		20		21		22		23		24		
9													
10	30		29		28		27		26		25		
11													
12	31		32		33		34		35		36		
13													

**Daniel E. Johnson**                      **Jan. 30**                      **95**  
 I, \_\_\_\_\_, in a field survey on \_\_\_\_\_, 19\_\_\_\_

do hereby certify that under requirements of P.A. 74, Michigan P.A. of 1970, the corner points mentioned in lines 1 and 2 above were in conformance with regulations and rules therefore as required in the current manual of survey instructions of the United States Department of the Interior, Bureau of Land Management or by a decree of a Court of Law and/or that the corner points mentioned in lines 3, 4 and 5 above were in conformance with the rules of the Michigan Board of Land Surveyors or by a Decree of a Court of Law; established, re-established, monumented, re-monumented, recovered, found as expressed below:

**NOTE: Not more than 1 corner, may be recorded on this certificate.**

A. Description of original monument and accessories and/or subsequent restoration:

**LIBER 007 PAGE 132**


STATE PLAIN COORDINATES

N. \_\_\_\_\_  
 E. \_\_\_\_\_

B. Description of corner evidence found and/or method applied in restoring or reestablishing corner:

**LIBER 007 PAGE 132**

ELEVATION \_\_\_\_\_

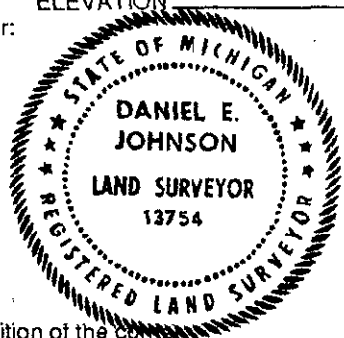

C. Description of monument for corner and accessories established to perpetuate locating the position of the corner:  
**Set 1/2" Rebar with 2" dia. aluminum cap inscribed "St. Clair County Official Corner" with magnet (in Monument Box)**

**S'ly 49.96 ft. set PK nail & tag in D.E. Pole  
 N.E. 54.70 ft. set PK nail & tag in D.E. Pole  
 N.W. 92.80 ft. set PK nail & tag in D.E. Pole  
 (corner is on centerline of existing Lapeer Road Pav't)**

Signed by *Daniel E. Johnson*  
Daniel E. Johnson  
 13754  
 Surveyor's Michigan License No. \_\_\_\_\_

Date January 30, 1995

APPROVED AS AN OFFICIAL GOVERNMENT CORNER BY ST. CLAIR COUNTY:

Signed By: *Daniel E. Johnson*  
 St. Clair County Land Surveyor **Daniel E. Johnson**  
 13754  
 Surveyor's Michigan License No. \_\_\_\_\_

PA 345-1990  
 PEER COMMITTEE  
 APPROVED 11-23-93  
7-31-95  
 Date \_\_\_\_\_  
 LIBER **008** PAGE **145**