

ST. CLAIR COUNTY, MICHIGAN OFFICIAL GOVERNMENT CORNER



LAND CORNER RECORDATION CERTIFICATE Filing Requirement of Act 74, Mich. P.A. 1970

	Located In:	Corner Code #	
1. Public Land Survey	Kimball Twp. T <u>6N.</u> R <u>16E.</u>	<u>K-1</u>	
	T _____ R _____	_____	
	T _____ R _____	_____	
	T _____ R _____	_____	
2. Property Controlling in Section	S _____ T _____ R _____	<u>Sec. 2</u>	
	S _____ T _____ R _____	_____	
3. Miscellaneous Property in Sec.	S _____ T _____ R _____	_____	
	S _____ T _____ R _____	_____	

RECEIVED
OFFICE OF REGISTER
ST. CLAIR COUNTY
1995 AUG - 4 AM 10: 11
Register of Deeds Stamp & File Number

4. Lot No. _____, Recorded Plat _____
5. Private Claims _____

	A	B	C	D	E	F	G	H	I	J	K	L	M
2	6	5	4	3	2	1							
3													
4	7	8	9	10	11	12							
5													
6	18	17	16	15	14	13							
7													
8	19	20	21	22	23	24							
9													
10	30	29	28	27	26	25							
11													
12	31	32	33	34	35	36							
13													

I, Daniel E. Johnson, in a field survey on May 11, 1995, do hereby certify that under requirements of P.A. 74, Michigan P.A. of 1970, the corner points mentioned in lines 1 and 2 above were in conformance with regulations and rules therefore as required in the current manual of survey instructions of the United States Department of the Interior, Bureau of Land Management or by a decree of a Court of Law and/or that the corner points mentioned in lines 3, 4 and 5 above were in conformance with the rules of the Michigan Board of Land Surveyors or by a Decree of a Court of Law; established, re-established, monumented, re-monumented, recovered, found as expressed below:

NOTE: Not more than 1 corner, may be recorded on this certificate.

A. Description of original monument and accessories and/or subsequent restoration:

LIBER 007 PAGE 353

STATE PLAIN COORDINATES


N. _____

E. _____

ELEVATION _____

B. Description of corner evidence found and/or method applied in restoring or reestablishing corner:

LIBER 007 PAGE 353

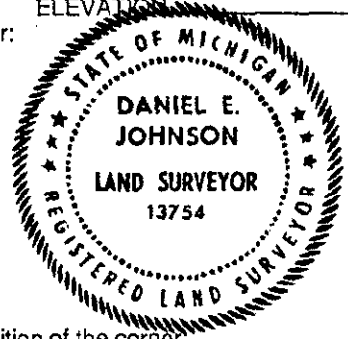

C. Description of monument for corner and accessories established to perpetuate locating the position of the corner:
Set 1/2"x18"Rerod with 2" dia. aluminum cap inscribed "St. Clair County Official Corner" with magnet (in monument box)

Located 1.07' North of the true Township line.

- S 30°E 86.94' to set PK nail w/county remon tag in NE side power pole
- N 72°E 117.70' to set PK nail w/county remon tag in SE side 15" Oak Tree
- N 20°W 103.16' to set PK nail w/county remon tag in E side 15" Pine Tree
- S 58°W 64.42' to set PK nail w/county remon tag in N side 6" Maple Tree
- WEST 2702.67' to the N. 1/4 corner of Section 2, T6N-R16E
- EAST 2771.70' to the N. 1/4 corner of Section 1, T6N-R16E

Signed by Daniel E. Johnson Date My 11, 1995
 Daniel E. Johnson
 Surveyor's Michigan License No. 13754

PA 345-1990
PEER COMMITTEE

APPROVED AS AN OFFICIAL GOVERNMENT CORNER BY ST. CLAIR COUNTY:

Signed By: Daniel E. Johnson
 St. Clair County Land Surveyor Daniel E. Johnson

APPROVED 6-17-94
7-31-95

Surveyor's Michigan License No. 13754

Date
LIBER 008 PAGE 130