

ST. CLAIR COUNTY, MICHIGAN OFFICIAL GOVERNMENT CORNER



LAND CORNER RECORDATION CERTIFICATE Filing Requirement of Act 74, Mich. P.A. 1970

Located In: _____ Corner Code # _____

Kimball Twp.

- | | | | | | | |
|------------------------------------|---|----|---|------|------|--|
| 1. Public Land Survey | T | 6N | R | 16E. | A-10 | |
| | T | | R | | | |
| | T | | R | | | |
| | T | | R | | | |
| | T | | R | | | |
| 2. Property Controlling in Section | S | | T | | R | |
| | S | | T | | R | |
| 3. Miscellaneous Property in Sec. | S | | T | | R | |
| | S | | T | | R | |

RECEIVED
REGISTERED DEEDS
ST. CLAIR COUNTY

1995 AUG -4 AM 10:18

Register of Deeds Stamp & File Number

4. Lot No. _____, Recorded Plat _____
5. Private Claims _____

	A	B	C	D	E	F	G	H	I	J	K	L	M
2	6		5		4		3		2		1		
3													
4	7		8		9		10		11		12		
5													
6	18		17		16		15		14		13		
7													
8	19		20		21		22		23		24		
9													
10	30		29		28		27		26		25		
11													
12	31		32		33		34		35		36		
13													

Daniel E. Johnson **January 31** **95**

I, _____, in a field survey on _____, 19_____, do hereby certify that under requirements of P.A. 74, Michigan P.A. of 1970, the corner points mentioned in lines 1 and 2 above were in conformance with regulations and rules therefore as required in the current manual of survey instructions of the United States Department of the Interior, Bureau of Land Management or by a decree of a Court of Law and/or that the corner points mentioned in lines 3, 4 and 5 above were in conformance with the rules of the Michigan Board of Land Surveyors or by a Decree of a Court of Law: established, re-established, monumented, re-monumented, recovered, found as expressed below:

NOTE: Not more than 1 corner, may be recorded on this certificate.

A. Description of original monument and accessories and/or subsequent restoration:

LIBER 007 PAGE 102

STATE PLAIN COORDINATES


N. _____

E. _____

ELEVATION _____

B. Description of corner evidence found and/or method applied in restoring or reestablishing corner:

LIBER 007 PAGE 102

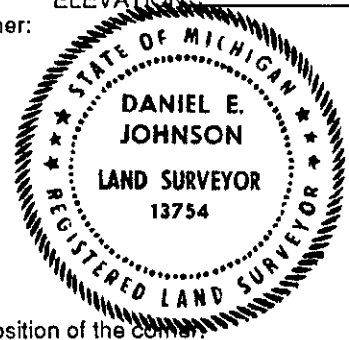

C. Description of monument for corner and accessories established to perpetuate locating the position of the corner:
Set 2" dia. aluminum cap inscribed "St. Clair County Official Corner" with magnet on an IRON ROD WITH CAP RLS 19835
Easterly 15.50 Set PK Nail & County Tag in Utility Pole
N'y 69 ft. to centerline of D.E. High Ten. Line Crossing (E. & W)
Northerly 30.96 ft. to East 1/4 Corner of Sec. 25 T.6N., R.15E.

Signed by *Daniel E. Johnson* Date January 31, 1995
 Daniel E. Johnson
 13754
 Surveyor's Michigan License No. _____

PA 345-1990
 PEER COMMITTEE
 APPROVED 11-16-93 *DWS*

APPROVED AS AN OFFICIAL GOVERNMENT CORNER BY ST. CLAIR COUNTY:

Signed By: *Daniel E. Johnson* Date 7-31-95
 St. Clair County Land Surveyor **Daniel E. Johnson**
 13754

LIBER **008** PAGE **136**

Surveyor's Michigan License No. _____