

**ST. CLAIR COUNTY, MICHIGAN  
OFFICIAL GOVERNMENT CORNER**



**LAND CORNER RECORDATION CERTIFICATE  
Filing Requirement of Act 74, Mich. P.A. 1970**

Located In: \_\_\_\_\_ Corner Code #/ \_\_\_\_\_

- |                                    |   |       |   |       |       |
|------------------------------------|---|-------|---|-------|-------|
| 1. Public Land Survey              |   |       |   |       |       |
|                                    | T | 6N.   | R | 16E.  | A-8   |
|                                    | T | _____ | R | _____ | _____ |
|                                    | T | _____ | R | _____ | _____ |
|                                    | T | _____ | R | _____ | _____ |
| 2. Property Controlling in Section | S | _____ | T | _____ | _____ |
|                                    | S | _____ | T | _____ | _____ |
| 3. Miscellaneous Property in Sec.  | S | _____ | T | _____ | _____ |
|                                    | S | _____ | T | _____ | _____ |

RECEIVED  
REGISTER OF DEEDS  
ST. CLAIR COUNTY  
1995 AUG -4 AM 10:18  
Register of Deeds Stamp & File Number

4. Lot No. \_\_\_\_\_, Recorded Plat \_\_\_\_\_  
5. Private Claims \_\_\_\_\_

	A	B	C	D	E	F	G	H	I	J	K	L	M
2	6	5	4	3	2	1							
3													
4	7	8	9	10	11	12							
5													
6	10	17	16	15	14	13							
7													
8	19	20	21	22	23	24							
9													
10	30	29	28	27	26	25							
11													
12	31	32	33	34	35	36							
13													

**Daniel E. Johnson** January 30 1995

I, \_\_\_\_\_, in a field survey on \_\_\_\_\_, 19\_\_\_\_, do hereby certify that under requirements of P.A. 74, Michigan P.A. of 1970, the corner points mentioned in lines 1 and 2 above were in conformance with regulations and rules therefore as required in the current manual of survey instructions of the United States Department of the Interior, Bureau of Land Management or by a decree of a Court of Law and/or that the corner points mentioned in lines 3, 4 and 5 above were in conformance with the rules of the Michigan Board of Land Surveyors or by a Decree of a Court of Law; established, re-established, monumented, re-monumented, recovered, found as expressed below:

**NOTE: Not more than 1 corner, may be recorded on this certificate.**

A. Description of original monument and accessories and/or subsequent restoration:

**LIBER 007 PAGE 110**

STATE PLAIN COORDINATES


N. \_\_\_\_\_

E. \_\_\_\_\_

ELEVATION \_\_\_\_\_

B. Description of corner evidence found and/or method applied in restoring or reestablishing corner:

**LIBER 007 PAGE 110**

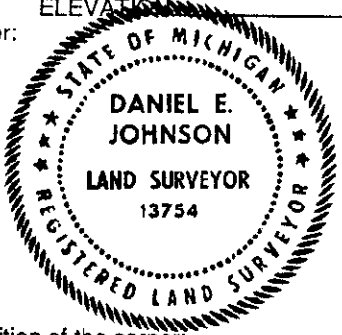

C. Description of monument for corner and accessories established to perpetuate locating the position of the corner:

Set 2" dia. aluminum cap inscribed "St. Clair County Official Corner" with magnet on a IRON ROD.  
 N.W. 55.87 ft. Set PK Nail & Tag in 36" Maple  
 Easterly 28.45 ft. " " " " P. Pole  
 N.E. 73.90 ft. " " " " 15" Elm  
 Northerly 43.00 ft. to East 1/4 Corner of Sec. 24T.6N., R.15E.

Signed by Daniel E. Johnson Date January 30, 1995  
 Surveyor's Michigan License No. 13754

PA 345-1990  
 PEER COMMITTEE  
 APPROVED 11-16-93  
*Dave J*

APPROVED AS AN OFFICIAL GOVERNMENT CORNER BY ST. CLAIR COUNTY:  
 Signed By: Daniel E. Johnson Date 7-31-95  
 St. Clair County Land Surveyor **Daniel E. Johnson**  
 13754  
 Surveyor's Michigan License No. \_\_\_\_\_

LIBER **008** PAGE **138**