ST. CLAIR COUNTY, MICHIGAN
OFFICIAL GOVERNMENT CORNER

LAND CORNER RECORDATION CERTIFICATE
Filing Requirement of Act 74, Mich. P.A. 1970

		Located In:	Corner Code #
1. Public Land Survey		Kimball Twp. T ~~6N.~~ R ~~16E.~~	~~I-1~~
		T ____ R ____	
		T ____ R ____	
		T ____ R ____	
2. Property Controlling	S ____	T ____ R ____	
in Section	S ____	T ____ R ____	Seg. 2
3. Miscellaneous	S ____	T ____ R ____	
Property in Sec.	S ____	T ____ R ____	

RECEIVED
REGISTER OF DEEDS
ST. CLAIR COUNTY
1995 AUG -4 AM 10: 1

Register of Deeds Stamp & File Number

4. Lot No. _____ , Recorded Plat _____
5. Private Claims _____

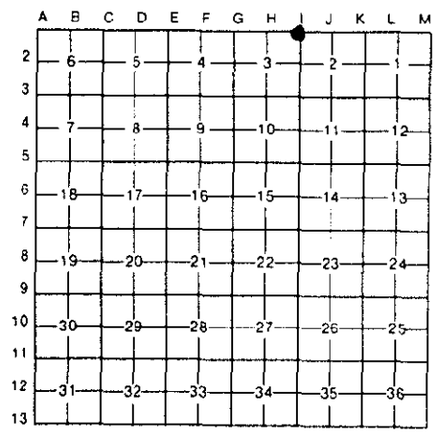

I, Daniel E. Johnson, in a field survey on May 11, 19 95, do hereby certify that under requirements of P.A. 74, Michigan P.A of 1970, the corner points mentioned in lines 1 and 2 above were in conformance with regulations and rules therefore as required in the current manual of survey instructions of the United States Department of the Interior, Bureau of Land Management or by a decree of a Court of Law and/or that the corner points mentioned in lines 3, 4 and 5 *above were in conformance with the rules of the Michigan Board of Land Surveyors or by a Decree of a* Court of Law; established, re-established, monumented, re-monumented, recovered, found as expressed below:

NOTE: Not more than 1 corner, may be recorded on this certificate.

A. Description of original monument and accessories and/or subsequent restoration:

LIBER 007 PAGE 355

STATE PLAIN COORDINATES

N. _____

E. _____

ELEVATION _____

B. Description of corner evidence found and/or method applied in restoring or reestablishing corner:

LIBER 007 PAGE 355

STATE OF MICHIGAN
DANIEL E. JOHNSON
LAND SURVEYOR
13754
REGISTERED LAND SURVEYOR

C. Description of monument for corner and accessories established to perpetuate locating the position of the corner:

Set 2" dia. aluminum cap inscribed "St. Clair County Official Corner" with magnet on a Capped 1/2" rerod #24608. Located on the true Township line.
N.N.E. 104.17' to set PK nail w/county remon tag in SE side 6" Elm tree
WEST 119.00' to set PK nail w/county remon tag in N. side 5" Poplar Tree
N.E. 151.05' to set PK nail w/county remon tag in NW side 10" Elm Tree
SOUTH 539' to north bank of Black River
WEST 2710.13' to N 1/4 corner of Section 3, T6N-R16E
EAST 2702.67' to N 1/4 corner of Section 2, T6N-R16E
SOUTH 2868.18' to 1/4 corner common to Sections 2 & 3, T6N-R16E

Signed by Daniel E. Johnson Date May 11, 1995
Daniel E. Johnson
Surveyor's Michigan License No. ~~13754~~

PA 345-1990
~~PEER COMMITTEE~~
APPROVED 6-24-94

APPROVED AS AN OFFICIAL GOVERNMENT CORNER BY ST. CLAIR COUNTY:

Signed By: Daniel E. Johnson : 7-31-95
St. Clair County Land Surveyor Daniel E. Johnson 13754 Date

Surveyor's Michigan License No. _____

LIBER 008 PAGE 128