

ST. CLAIR COUNTY, MICHIGAN OFFICIAL GOVERNMENT CORNER



LAND CORNER RECORDATION CERTIFICATE Filing Requirement of Act 74, Mich. P.A. 1970

Located In: _____ Corner Code # _____

	Kimball Twp.		
1. Public Land Survey	T <u>6N.</u> R <u>16E.</u>		<u>M-1</u>
	T _____ R _____		_____
	T _____ R _____		_____
	T _____ R _____		_____
2. Property Controlling in Section	S _____ T _____ R _____		<u>Sec. 2</u>
	S _____ T _____ R _____		_____
3. Miscellaneous Property in Sec.	S _____ T _____ R _____		_____
	S _____ T _____ R _____		_____

RECEIVED
REGISTER OF DEEDS
ST. CLAIR COUNTY
1995 AUG -41 AM 10:38
Register of Deeds Stamp & File Number

4. Lot No. _____, Recorded Plat _____
5. Private Claims _____

Daniel E. Johnson **May 11** **95**
I, _____, in a field survey on _____, 19____, do hereby certify that under requirements of P.A. 74, Michigan P.A. of 1970, the corner points mentioned in lines 1 and 2 above were in conformance with regulations and rules therefore as required in the current manual of survey instructions of the United States Department of the Interior, Bureau of Land Management or by a decree of a Court of Law and/or that the corner points mentioned in lines 3, 4 and 5 above were in conformance with the rules of the Michigan Board of Land Surveyors or by a Decree of a Court of Law; established, re-established, monumented, re-monumented, recovered, found as expressed below:

	A	B	C	D	E	F	G	H	I	J	K	L	M
2	6		5		4		3		2		1		
3													
4	7		8		9		10		11		12		
5													
6	18		17		16		15		14		13		
7													
8	19		20		21		22		23		24		
9													
10	30		29		28		27		26		25		
11													
12	31		32		33		34		35		36		
13													

NOTE: Not more than 1 corner, may be recorded on this certificate.

A. Description of original monument and accessories and/or subsequent restoration:

LIBER 007 PAGE 351

STATE PLAIN COORDINATES


N. _____

E. _____

ELEVATION _____

B. Description of corner evidence found and/or method applied in restoring or reestablishing corner:

LIBER 007 PAGE 351

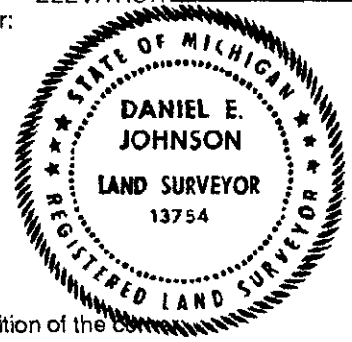

C. Description of monument for corner and accessories established to perpetuate locating the position of the corner:
Set 1/2" Rebar with 2" dia. aluminum cap inscribed "St. Clair County Official Corner" with magnet (in monument box) on a
1 1/2" iron pipe in monument box in centerline of existing pavement of W. Water St. and Range Rd. to south. Corner common to A-1, T6N-R17E, Port Huron Twp. Located on the true Township line.
S 54°E 70.71' to set PK nail w/county remon tag in N side power pole
N 42°30'E 74.21' to set PK nail w/county remon tag in W side power pole
N 65°W 95.82' to set PK nail w/county remon tag in S side pwer pole
S 40°W 41.74' to set PK nail w/county remon tag in NW side power pole
WEST 2768.57' to N 1/4 corner, Section 1, T6N-R16E
EAST 2648.11' to N 1/4 corner, Section 6, T6N-R17E

Signed by _____ Date May 11, 1995

Daniel E. Johnson
Daniel E. Johnson #13754

Surveyor's Michigan License No. _____

PA 345-1990
PEER COMMITTEE

APPROVED AS AN OFFICIAL GOVERNMENT CORNER BY ST. CLAIR COUNTY:

Signed By: _____
St. Clair County Land Surveyor **Daniel E. Johnson**

APPROVED 6-17-94
Dave J

7-31-95

LIBER **008** PAGE **132**

Surveyor's Michigan License No. 13754