

SURVEY &
REMONUMENTATION

JUL 14 1997

ST. CLAIR COUNTY, MICHIGAN OFFICIAL GOVERNMENT CORNER



LAND CORNER RECORDATION CERTIFICATE
Filing Requirement of Act 74, Mich. P.A. 1970.

RECEIVED
MAYOR DUNN
1996 JUL 31 AM 8:01
REGISTER OF DEEDS
ST. CLAIR COUNTY

Register of Deeds Stamp & File Number

	Located In:	Corner Code #
	Port Huron Township	
1. Public Land Survey	T <u>6</u> R <u>17</u>	<u>A-7</u>
	T _____ R _____	_____
	T _____ R _____	_____
	T _____ R _____	_____
2. Property Controlling in Section	S _____ T _____ R _____	_____
	S _____ T _____ R _____	_____
3. Miscellaneous Property in Sec.	S _____ T _____ R _____	_____
	S _____ T _____ R _____	_____
4. Lot No. _____, Recorded Plat _____		
5. Private Claims _____		

I, John C. Niederhauser, in a field survey on June 21, 19 95

do hereby certify that under requirements of P.A. 74, Michigan P.A. of 1970, the corner points mentioned in lines 1 and 2 above were in conformance with regulations and rules therefore as required in the current manual of survey instructions of the United States Department of the Interior, Bureau of Land Management or by a decree of a Court of Law and/or that the corner points mentioned in lines 3, 4 and 5 above were in conformance with the rules of the Michigan Board of Land Surveyors or by a Decree of a Court of Law; established, re-established, monumented, re-monumented, recovered, found as expressed below:

NOTE: Not more than 1 corner, may be recorded on this certificate.

	A	B	C	D	E	F	G	H	I	J	K	L	M
2	6	5	4	3	2	1							
3													
4	7	8	9	10	11	12							
5													
6	18	17	16	15	14	13							
7													
8	19	20	21	22	23	24							
9													
10	30	29	28	27	26	25							
11													
12	31	32	33	34	35	36							
13													

A. Description of original monument and accessories and/or subsequent restoration:

Original corner set on a 6" diameter Black Ash tree by William Preston in 1817. Nothing listed on Old County Surveyor's Record for St. Clair County, except witnesses. Corner recovered and recorded by C. Alloway Liber 3, Page 9; by B. Collins Liber 4, Page 256; by L. Thomas Liber 5, Page 181; by R. Kreger Liber 6, Page 17 and by C. McDaniel Liber 6, Page 348.

B. Description of corner evidence found and/or method applied in restoring or reestablishing corner:

Found P.K. nail on centerline of existing Range Road pavement. Verified corner from previously recorded witnesses. Referenced Old County Surveyor's Record of St. Clair County and M.D.O.T. R.O.W. book for St. Clair County, Page 106. Also referenced surveys by L. Thomas dated 9-9-70, 2-3-81 and 6-14-67; by R. Kreger 5-8-81 and 6-9-81; by C. McDaniel 5-8-91 and by J. Niederhauser 4-28-87, 11-18-91, 9-17-90 and 8-10-94. This corner is common to corner M-7 of T6N - R16E and can be referenced for additional information.


C. Description of monument for corner and accessories established to perpetuate locating the position of the corner:

Set a 2" dia. aluminum cap with a magnet, inscribed "St. Clair County Official Corner" on a 1/2" iron rod in a monument box on centerline of existing Range Road pavement. Located on the true Township line and is common to corner M-7 of T6N - R16E.
S 80°W 23.92' to set P.K. nail with county remon tag in S.E. side of a wood guard rail post
N 40°W 44.52' to set P.K. nail with county remon tag in E. side 9th Guard rail post from S.
N 45°E 45.80' to set "x" on S.W. anchor bolt of road sign for expressway.
NORTH 2767.30' to corner A-6 of T6N - R17E.
NORTH 601.00' to centerline of east bound lane of I-94 expressway.
SOUTH 2700.52' to corner A-8 of T6N - R17E

Signed by _____

PA 345-1990
PEER COMMITTEE
APPROVED 7-21-95
Daniel Johnson
Date

May 30, 1996

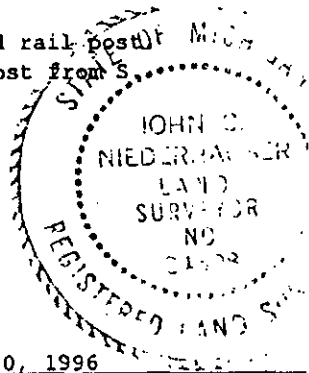

Surveyor's Michigan License No. 24608

LIBR 008 PAGE 302