

SURVEY & REMONUMENTATION

JUL 14 1997

COMMISSION

ST. CLAIR COUNTY, MICHIGAN OFFICIAL GOVERNMENT CORNER



LAND CORNER RECORDATION CERTIFICATE Filing Requirement of Act 74, Mich. P.A. 1970

RECEIVED MARYLINDA DUNN REGISTER OF DEEDS ST. CLAIR COUNTY 1996 JUL 31 AM 8:02 Register of Deeds Stamp & File Number

	Located In:	Corner Code #
	City of Marysville	A-11
1. Public Land Survey	T <u>6</u> R <u>17</u>	_____
	T _____ R _____	_____
	T _____ R _____	_____
	T _____ R _____	_____
2. Property Controlling in Section	S _____ T _____ R _____	_____
	S _____ T _____ R _____	_____
3. Miscellaneous Property in Sec.	S _____ T _____ R _____	_____
	S _____ T _____ R _____	_____

4. Lot No. _____, Recorded Plat _____
5. Private Claims _____

I, John C. Niederhauser, in a field survey on June 26, 1995, do hereby certify that under requirements of P.A. 74, Michigan P.A. of 1970, the corner points mentioned in lines 1 and 2 above were in conformance with regulations and rules therefore as required in the current manual of survey instructions of the United States Department of the Interior, Bureau of Land Management or by a decree of a Court of Law and/or that the corner points mentioned in lines 3, 4 and 5 above were in conformance with the rules of the Michigan Board of Land Surveyors or by a Decree of a Court of Law; established, re-established, monumented, re-monumented, recovered, found as expressed below:

NOTE: Not more than 1 corner, may be recorded on this certificate.

A	B	C	D	E	F	G	H	I	J	K	L	M
2	6	5	4	3	2	1						
3												
4	7	8	9	10	11	12						
5												
6	18	17	16	15	14	13						
7												
8	19	20	21	22	23	24						
9												
10	30	29	28	27	26	25						
11												
12	31	32	33	34	35	36						
13												

A. Description of original monument and accessories and/or subsequent restoration: Original corner set on a 12" diameter White Ash tree by William Preston in 18.17 Stone listed on Old County Surveyor's Record for St. Clair County. Corner recovered and recorded by C. Alloway Liber3, Page 7 for M-11 of T6N-R16E and by B. Collins Liber 4, Page 207 for M-11 of T6N-R16E, which is common to A-11. Corner listed on plats Liber 29, page 4 and Liber 55, Page 29.


B. Description of corner evidence found and/or method applied in restoring or reestablishing corner: Found 3/8" iron rod in monument box at the intersection of Range Road and Smiths Creek Road to the west and Sixth Street to the east. Referenced subdivision plats Liber 29, Page 4 and Liber 55, Page 29. This corner is common to corner M-11 of T6N-R16E and can be referenced for additional information.

C. Description of monument for corner and accessories established to perpetuate locating the position of the corner:

Set a 2" dia. Aluminum cap with a magnet inscribed "St. Clair County Official Corner" on a 3/8" iron rod in monument box at the intersection of Range Road and Smiths Creek Road to the west and Sixth Street to the east. Located on the true Township line and is common to corner M-11 of T6N-R16E.

- N 40°W 77.52' to set P.K. nail with county remon tag in W. side of a power pole.
- S 45°W 65.88' to set P.K. nail with county remon tag in E. side of a power pole.
- S 45°W 61.07' to set P.K. nail with county remon tag in W. side of a power pole.
- N 35 E 73.75' to set P.K. nail with county remon tag in top of S. guard rail post.
- NORTH 2761.93' to corner A-10 of T6N-R17E.
- SOUTH 2703.94' to corner A-12 of T6N-R17E.
- SOUTH 1474.87' to found P.K. nail at centerline of 9th Street to the west.

PA 345-1990 PEER COMMITTEE APPROVED 7-21-95 *Daniel Johnson*

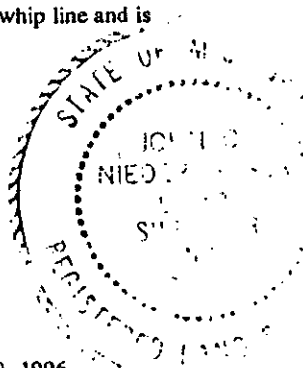

Signed by _____ Date May 30, 1996

Surveyor's Michigan License No. 24608

FILED 008 307