ST. CLAIR COUNTY, MICHIGAN
OFFICIAL GOVERNMENT CORNER

LAND CORNER RECORDATION CERTIFICATE
Filing Requirement of Act 74, Mich. P.A. 1970

	Located In:	Corner Code #
1. Public Land Survey	Port Huron Twp. T 6N. R 17E.	B-1
	T ____ R ____	
	T ____ R ____	
	T ____ R ____	
2. Property Controlling	S ____ T ____ R ____	Leg. 2
in Section	S ____ T ____ R ____	
3. Miscellaneous	S ____ T ____ R ____	
Property in Sec.	S ____ T ____ R ____	

RECEIVED
1995 MAY -4 AM 10:23
ST. CLAIR COUNTY
REGISTER OF DEEDS

Register of Deeds Stamp & File Number

4. Lot No. _____, Recorded Plat _____
5. Private Claims _____

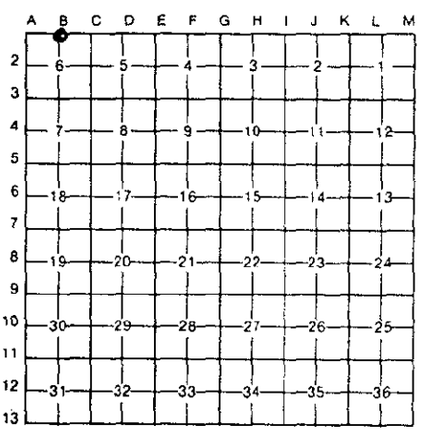

I, Daniel E. Johnson, in a field survey on May 25, 19 95, do hereby certify that under requirements of P.A. 74, Michigan P.A. of 1970, the corner points mentioned in lines 1 and 2 above were in conformance with regulations and rules therefore as required in the current manual of survey instructions of the United States Department of the Interior, Bureau of Land Management or by a decree of a Court of Law and/or that the corner points mentioned in lines 3, 4 and 5 above were in conformance with the rules of the Michigan Board of Land Surveyors or by a Decree of a Court of Law, established, re-established, monumented, re-monumented, recovered, found as expressed below:

NOTE: Not more than 1 corner, may be recorded on this certificate.

A. Description of original monument and accessories and/or subsequent restoration:

LIBER 007 PAGE 379

STATE PLAIN COORDINATES

N. _____

E. _____

ELEVATION _____

B. Description of corner evidence found and/or method applied in restoring or reestablishing corner:

LIBER 007 PAGE 379

STATE OF MICHIGAN
DANIEL E. JOHNSON
LAND SURVEYOR
13754
REGISTERED LAND SURVEYOR

C. Description of monument for corner and accessories established to perpetuate locating the position of the corner:

Set 1/2" x 18" Rerod with 2" dia. aluminum cap inscribed "St. Clair County Official Corner" with magnet (in monument box) on a 1/2" iron rerod with illegible cap on centerline of existing W Water St pavement. Located on the true Township line.
N 52°30'W 61.87' to set PK nail w/county remon tag in NE side power pole
SOUTH 27.74' to set PK nail w/county remon tag in E side power pole
S 45°E 72.36' to set PK nail w/county remon tag in N side 24" pine tree
N 75°E 128.93' to set PK nail w/county remon tag in NE side power pole
WEST 2648.11' to NW corner Section 6, T6N-R17E
EAST 2666.17' to NE corner Section 6, T6N-R17E

Signed by Daniel E. Johnson Date May 25, 1995

Daniel E. Johnson

Surveyor's Michigan License No. 13754

PA 345-1990
PEER COMMITTEE
APPROVED 6-17-94

APPROVED AS AN OFFICIAL GOVERNMENT CORNER BY ST. CLAIR COUNTY:

Signed By: Daniel E. Johnson : 7-31-95

St. Clair County Land Surveyor Daniel E. Johnson Date

13754

Surveyor's Michigan License No. _____

LIBER 008 PAGE 167