

RECEIVED  
MAY 25 1994

ST. CLAIR COUNTY, MICHIGAN  
OFFICIAL GOVERNMENT CORNER



1994 SEP 20 PM 2:23

REGISTER OF DEEDS  
ST. CLAIR COUNTY

LAND CORNER RECORDATION CERTIFICATE  
Filing Requirement of Act 74, Mich. P.A. 1970

Located In: Port Huron Township Corner Code ##  
E-1

1. Public Land Survey T 6N R 17E  
 T \_\_\_\_\_ R \_\_\_\_\_  
 T \_\_\_\_\_ R \_\_\_\_\_  
 T \_\_\_\_\_ R \_\_\_\_\_

2. Property Controlling S \_\_\_\_\_ T \_\_\_\_\_ R \_\_\_\_\_  
 in Section S \_\_\_\_\_ T \_\_\_\_\_ R \_\_\_\_\_ *Seg-1*

3. Miscellaneous S \_\_\_\_\_ T \_\_\_\_\_ R \_\_\_\_\_  
 Property in Sec. S \_\_\_\_\_ T \_\_\_\_\_ R \_\_\_\_\_

4. Lot No. \_\_\_\_\_, Recorded Plat \_\_\_\_\_

5. Private Claims \_\_\_\_\_

Register of Deeds Stamp & File Number

A	B	C	D	E	F	G	H	I	J	K	L	M
2	6	5	4	3	2	1						
3												
4	7	8	9	10	11	12						
5												
6	18	17	16	15	14	13						
7												
8	19	20	21	22	23	24						
9												
10	30	29	28	27	26	25						
11												
12	31	32	33	34	35	36						
13												

I, John C. Niederhauser, in a field survey on March 25, 1994, do hereby certify that under requirements of P.A. 74, Michigan P.A. of 1970, the corner points mentioned in lines 1 and 2 above were in conformance with regulations and rules therefore as required in the current manual of survey instructions of the United States Department of the Interior, Bureau of Land Management or by a decree of a Court of Law and/or that the corner points mentioned in lines 3, 4 and 5 above were in conformance with the rules of the Michigan Board of Land Surveyors or by a Decree of a Court of Law, established, re-established, monumented, re-monumented, recovered, found as expressed below:

NOTE: Not more than 1 corner, may be recorded on this certificate.

A. Description of original monument and accessories and/or subsequent restoration:

Wood post set by William Preston in 1817. Nothing listed on Old Surveyor's Record, St. Clair County. Corner recovered and recorded by C. Alloway, Liber 2, page 351, 1/2" rered listed. 1 1/2" iron pipe listed in St. Clair County Road Commission corner book, page 133.

STATE PLAIN COORDINATES

N. \_\_\_\_\_

E. \_\_\_\_\_

ELEVATION \_\_\_\_\_

B. Description of corner evidence found and/or method applied in restoring or reestablishing corner:

Found railroad spike in centerline of existing West Water Street pavement in line with old fence line to south. Verified corner from previously recorded witnesses and from recorded "Supervisor's Water Street Plat," Liber 48, page 16. Also referenced "Floyd May Subdivision," Liber 62, page 1 and recorded survey by D. Little, Liber 12, page 375.

C. Description of monument for corner and accessories established to perpetuate locating the position of the corner:


Railroad spike in centerline of existing West Water Street pavement in line with old fence line to south. Located on the true Township line.

S 60°E 70.72' to set P.K. nail with county remon tag in N.N.E. side of power pole  
 SOUTH 41.33' to set P.K. nail with county remon tag in N. side 30" box elder tree  
 N 15°E 28.05' to set P.K. nail with county remon tag in S.E. side 12" maple tree  
 N 60°W 64.55' to set P.K. nail with county remon tag in S.E. side power pole  
 N 50°E 69.10' to S.E. corner of brick pillar  
 WEST 2715.91' to N. 1/4 corner of Section 5, T6N-R17E  
 EAST 2135.56' to reference point on west bank of Black River

Signed by John C. Niederhauser PA 345-1990 Date May 25, 1994

Surveyor's Michigan License No. 24608 PEER COMMITTEE

APPROVED 6-17-94

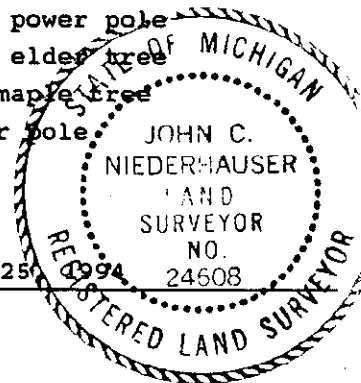

APPROVED AS AN OFFICIAL GOVERNMENT CORNER BY ST. CLAIR COUNTY:

Signed By: \_\_\_\_\_

St. Clair County Land Surveyor

Surveyor's Michigan License No. \_\_\_\_\_

LIBER 007 PAGE 376