

ST. CLAIR COUNTY, MICHIGAN OFFICIAL GOVERNMENT CORNER



LAND CORNER RECORDATION CERTIFICATE Filing Requirement of Act 74, Mich. P.A. 1970

Located In: _____ Corner Code # _____

Port Huron Twp.

- | | | | | |
|------------------------------------|--------------|----------------|-------------|--------------|
| 1. Public Land Survey | T <u>6N.</u> | R <u>R17E.</u> | E- <u>1</u> | |
| | T _____ | R _____ | _____ | |
| | T _____ | R _____ | _____ | |
| | T _____ | R _____ | _____ | |
| 2. Property Controlling in Section | S _____ | T _____ | R _____ | <i>Seg 2</i> |
| | S _____ | T _____ | R _____ | |
| | S _____ | T _____ | R _____ | |
| 3. Miscellaneous Property in Sec. | S _____ | T _____ | R _____ | |
| | S _____ | T _____ | R _____ | |

REGISTERED
ST. CLAIR COUNTY
1995 JUN -4 AM 11:23
RECEIVED
Register of Deeds Stamp & File Number

4. Lot No. _____, Recorded Plat _____
5. Private Claims _____

Daniel E. Johnson **May 24** **95**

I, _____, in a field survey on _____, 19____, do hereby certify that under requirements of P.A. 74, Michigan P.A. of 1970, the corner points mentioned in lines 1 and 2 above were in conformance with regulations and rules therefore as required in the current manual of survey instructions of the United States Department of the Interior, Bureau of Land Management or by a decree of a Court of Law and/or that the corner points mentioned in lines 3, 4 and 5 above were in conformance with the rules of the Michigan Board of Land Surveyors or by a Decree of a Court of Law; established, re-established, monumented, re-monumented, recovered, found as expressed below:

	A	B	C	D	E	F	G	H	I	J	K	L	M
2	6			5		4			3			2	
3													
4	7			8		9			10			11	12
5													
6	18			17		16			15			14	13
7													
8	19			20		21			22			23	24
9													
10	30			29		28			27			26	25
11													
12	31			32		33			34			35	36
13													

NOTE: Not more than 1 corner, may be recorded on this certificate.

A. Description of original monument and accessories and/or subsequent restoration:

LIBER 007 PAGE 376

STATE PLAIN COORDINATES


N. _____

E. _____

ELEVATION _____

B. Description of corner evidence found and/or method applied in restoring or reestablishing corner:

LIBER 007 PAGE 376

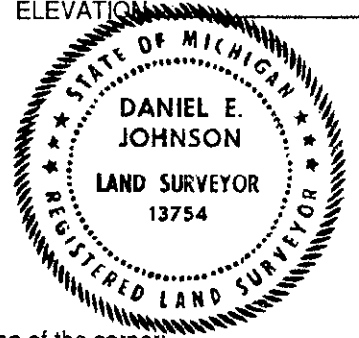

C. Description of monument for corner and accessories established to perpetuate locating the position of the corner:
 Set 1/2" x 18" rered with 2" dia. aluminum cap inscribed "St Clair County Official Corner" with magnet
 in centerline of existing W Water Street pavement in line with old fence line to south. Located on the true township line.
 S 60°E 70.72' to set PK nail w/county remon tag in NNE side of poewr pole
 South 41.33' to set PK nail w/county remon tag in N side 30" Box Elder Tree
 N 15°E 28.05' to set PK nail w/county remon tag in SE side 12" Maple Tree
 N 60°W 64.55' to set PK nail w/county remon tag in SE side power pole.
 N 50°E 69.10' to SE corner of brick pillar
 WEST 2715.91' to N 1/4 corner of Sectin 5, T6N-R17E
 EAST 2135.56' to reference point on west bank of Black River

Signed by Daniel E. Johnson Date May 24, 1995

Surveyor's Michigan License No. 13754

**PA 345-1990
PEER COMMITTEE**

APPROVED AS AN OFFICIAL GOVERNMENT CORNER BY ST. CLAIR COUNTY:

Signed By: Daniel E. Johnson : 7-31-95 Date

St. Clair County Land Surveyor **Daniel E. Johnson**

13754

Surveyor's Michigan License No. _____

LIBER **008** PAGE **170**