

ST. CLAIR COUNTY, MICHIGAN OFFICIAL GOVERNMENT CORNER



LAND CORNER RECORDATION CERTIFICATE Filing Requirement of Act 74, Mich. P.A. 1970

	Located in:	Corner Code #	
	Port Huron Twp		
1. Public Land Survey	T <u>6N</u> R <u>17E</u>	F-1 (Reference)	
	T _____ R _____	_____	
	T _____ R _____	_____	
	T _____ R _____	_____	
2. Property Controlling in Section	S _____ T _____ R _____	<i>Sec 2</i>	
	S _____ T _____ R _____	_____	
3. Miscellaneous Property in Sec.	S _____ T _____ R _____	_____	
	S _____ T _____ R _____	_____	

REGISTER OF DEEDS
 ST. CLAIR COUNTY, MICHIGAN
 JUN 10 - 11 10: 23
 REGISTER OF DEEDS STAMP & FILE NUMBER

4. Lot No. _____, Recorded Plat _____
 5. Private Claims _____

I, Daniel E. Johnson, in a field survey on May 11, 1995, do hereby certify that under requirements of P.A. 74, Michigan P.A. of 1970, the corner points mentioned in lines 1 and 2 above were in conformance with regulations and rules therefore as required in the current manual of survey instructions of the United States Department of the Interior, Bureau of Land Management or by a decree of a Court of Law and/or that the corner points mentioned in lines 3, 4 and 5 above were in conformance with the rules of the Michigan Board of Land Surveyors or by a Decree of a Court of Law, established, re-established, monumented, re-monumented, recovered, found as expressed below:

	A	B	C	D	E	F	G	H	I	J	K	L	M
2	6	5	4	3	2	1							
3													
4	7	8	9	10	11	12							
5													
6	18	17	16	15	14	13							
7													
8	19	20	21	22	23	24							
9													
10	30	29	28	27	26	25							
11													
12	31	32	33	34	35	36							
13													

NOTE: Not more than 1 corner, may be recorded on this certificate.

A. Description of original monument and accessories and/or subsequent restoration:

LIBER 007 PAGE 375


STATE PLAIN COORDINATES

N. _____

E. _____

B. Description of corner evidence found and/or method applied in restoring or reestablishing corner:

LIBER 007 PAGE 375

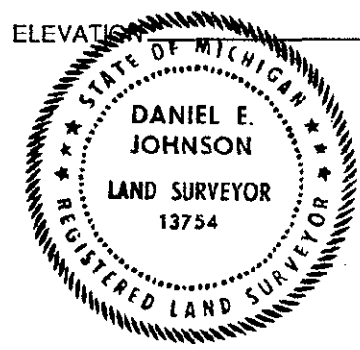

C. Description of monument for corner and accessories established to perpetuate locating the position of the corner:

Set 2" dia. aluminum cap inscribed "St. Clair County Official Corner" with magnet on a 3/4" rerod at margin (west bank) of Black River on centerline of West Water Street extended. Located on the true Township line.
 E.N.E. 35.08' to SW corner of Detroit Edison Co. steel tower.
 North 31.50 to W end of a steel seawall
 South 47.60' to set PK nail with county remon tag in W side of guy pole
 SE 36.00 to S end of a steel seawall
 West 2135.56' to NW corner of Section 4, T6N-R17E
 West 724.92' to 1/2 rerod in monument box on township line at centerline of intersection of Water Street and West Water Street.

Signed by Daniel E. Johnson Date May 11, 1995
 13754

Surveyor's Michigan License No. _____
 PA 345-1990
 PEER COMMITTEE
 APPROVED 6-10-94

APPROVED AS AN OFFICIAL GOVERNMENT CORNER BY ST. CLAIR COUNTY:
 Signed By: Daniel E. Johnson : 7-31-95
 St. Clair County Land Surveyor Date

Surveyor's Michigan License No. _____
 LIBER 008 PAGE 171