

ST. CLAIR COUNTY, MICHIGAN OFFICIAL GOVERNMENT CORNER



LAND CORNER RECORDATION CERTIFICATE Filing Requirement of Act 74, Mich. P.A. 1970

Located In: _____ Corner Code # _____

Port Huron Twp.

- | | | | | |
|------------------------------------|-------------|---------------|---------|--------------|
| 1. Public Land Survey | T <u>6N</u> | R <u>R17E</u> | C-1 | |
| | T _____ | R _____ | _____ | _____ |
| | T _____ | R _____ | _____ | _____ |
| | T _____ | R _____ | _____ | _____ |
| 2. Property Controlling in Section | S _____ | T _____ | R _____ | <i>Seg 2</i> |
| | S _____ | T _____ | R _____ | |
| | S _____ | T _____ | R _____ | |
| 3. Miscellaneous Property in Sec. | S _____ | T _____ | R _____ | _____ |

REGISTERED
 6-17-94
 11:10:23
 ST. CLAIR COUNTY
 REGISTERED

Register of Deeds Stamp & File Number

4. Lot No. _____, Recorded Plat _____
5. Private Claims _____

Daniel E. Johnson **May 11** **95**

I, _____, in a field survey on _____, 19_____, do hereby certify that under requirements of P.A. 74, Michigan P.A. of 1970, the corner points mentioned in lines 1 and 2 above were in conformance with regulations and rules therefore as required in the current manual of survey instructions of the United States Department of the Interior, Bureau of Land Management or by a decree of a Court of Law and/or that the corner points mentioned in lines 3, 4 and 5 above were in conformance with the rules of the Michigan Board of Land Surveyors or by a Decree of a Court of Law; established, re-established, monumented, re-monumented, recovered, found as expressed below:

NOTE: Not more than 1 corner, may be recorded on this certificate.

A. Description of original monument and accessories and/or subsequent restoration:

LIBER 007 PAGE 378

STATE PLAIN COORDINATES


N. _____

E. _____

B. Description of corner evidence found and/or method applied in restoring or reestablishing corner:

LIBER 007 PAGE 378

ELEVATION _____

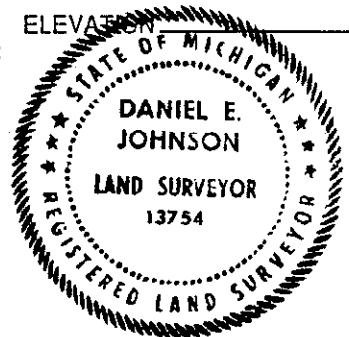

C. Description of monument for corner and accessories established to perpetuate locating the position of the corner:
Set with 2" dia. aluminum cap inscribed "St Clair County Official Corner" with magnet (in monument box) on a 5/8" iron rod in monument box, 1.0' north of centerline of existing W Water St. pavement and on centerline of existing Michigan Road pavement to south. Located 1.13 feet north of the true Township line.
 S 11°30'E 99.88' to set PK nail w/county remon tag in W side power pole
 S 45°30'W 47.18' to set PK nail w/county remon tag in SE side power pole
 N 56°30'W 57.07' to set PK nail w/county remon tag in NE side power pole
 N 61°E 63.68' to set PK nail w/county remon tag in SW side power pole
 WEST 2666.17' to N 1/4 corner Section 6, T6N-R17E
 EAST 2690.93' to N 1/4 corner Section 5, T6N-R17E

Signed by _____ Date MaY 11, 1995
Daniel E. Johnson
 Daniel E. Johnson

Surveyor's Michigan License No. 13754

**PA 345-1990
PEER COMMITTEE**

APPROVED AS AN OFFICIAL GOVERNMENT CORNER BY ST. CLAIR COUNTY:

Signed By: _____
Daniel E. Johnson
 Daniel E. Johnson
 St. Clair County Land Surveyor
 13754
 Surveyor's Michigan License No. _____

APPROVED 6-17-94
Danta

7-31-95
 Date

LIBER **008** PAGE **168**