

# ST. CLAIR COUNTY, MICHIGAN OFFICIAL GOVERNMENT CORNER

## LAND CORNER RECORDATION CERTIFICATE Filing Requirement of Act 74, Mich. P.A. 1970



RECEIVED  
 REGISTER OF DEEDS  
 ST. CLAIR COUNTY  
 05 JUN -4 AM 10:23

Located In: \_\_\_\_\_ Corner Code # \_\_\_\_\_

Port Huron Twp.

- |                                    |             |                |             |              |
|------------------------------------|-------------|----------------|-------------|--------------|
| 1. Public Land Survey              | T <u>6N</u> | R <u>R17E.</u> | D- <u>1</u> |              |
|                                    | T _____     | R _____        | _____       |              |
|                                    | T _____     | R _____        | _____       |              |
|                                    | T _____     | R _____        | _____       |              |
| 2. Property Controlling in Section | S _____     | T _____        | R _____     | <i>Sec 2</i> |
|                                    | S _____     | T _____        | R _____     |              |
|                                    | S _____     | T _____        | R _____     |              |
| 3. Miscellaneous Property in Sec.  | S _____     | T _____        | R _____     |              |
|                                    | S _____     | T _____        | R _____     |              |

Register of Deeds Stamp & File Number

4. Lot No. \_\_\_\_\_, Recorded Plat \_\_\_\_\_
5. Private Claims \_\_\_\_\_

**Daniel E. Johnson**                      **May 11**                      **95**

I, \_\_\_\_\_, in a field survey on \_\_\_\_\_, 19\_\_\_\_, do hereby certify that under requirements of P.A. 74, Michigan P.A. of 1970, the corner points mentioned in lines 1 and 2 above were in conformance with regulations and rules therefore as required in the current manual of survey instructions of the United States Department of the Interior, Bureau of Land Management or by a decree of a Court of Law and/or that the corner points mentioned in lines 3, 4 and 5 above were in conformance with the rules of the Michigan Board of Land Surveyors or by a Decree of a Court of Law; established, re-established, monumented, re-monumented, recovered, found as expressed below:

**NOTE: Not more than 1 corner, may be recorded on this certificate.**

	A	B	C	D	E	F	G	H	I	J	K	L	M
2	6	5	4	3	2	1							
3													
4	7	8	9	10	11	12							
5													
6	18	17	16	15	14	13							
7													
8	19	20	21	22	23	24							
9													
10	30	29	28	27	26	25							
11													
12	31	32	33	34	35	36							
13													

A. Description of original monument and accessories and/or subsequent restoration:

LIBER 007 PAGE 377


STATE PLAIN COORDINATES

N. \_\_\_\_\_  
E. \_\_\_\_\_

B. Description of corner evidence found and/or method applied in restoring or reestablishing corner:

LIBER 007 PAGE 377

ELEVATION \_\_\_\_\_

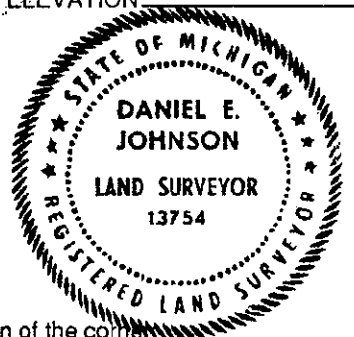

C. Description of monument for corner and accessories established to perpetuate locating the position of the corner:  
 Set with 2" dia. aluminum cap inscribed "St Clair County Official Corner" with magnet (in monument box) on a 1/2" iron rerod in monument box, 2' north of centerline of existing W Water St. pavement. Located 0.27' south of the true Township line.  
 S 45°E 55.65' to set PK nail w/county remon tag in SW side small tree  
 S 30°W 79.30' to set PK nail w/county remon tag in W side small tree  
 N 45°W 43.84' to set PK nail w/county remon tag in E side power pole  
 NORTH 59.22' to set PK nail w/county remon tag in W side power pole  
 WEST 2690.93' to NW corner Section 5, T6N-R17E  
 EAST 2715.91' to NE corner Section 5, T6N-R17E

Signed by Daniel E. Johnson                      Date May 11, 1995  
 Daniel E. Johnson

Surveyor's Michigan License No. 13754                      PA 345-1990  
 PEER COMMITTEE

APPROVED AS AN OFFICIAL GOVERNMENT CORNER BY ST. CLAIR COUNTY:

Signed By: Daniel E. Johnson                      Date 7-31-95  
 St. Clair County Land Surveyor Daniel E. Johnson

Surveyor's Michigan License No. 13754                      LIBER 008 PAGE 169