

ST. CLAIR COUNTY, MICHIGAN OFFICIAL GOVERNMENT CORNER



LAND CORNER RECORDATION CERTIFICATE Filing Requirement of Act 74, Mich. P.A. 1970

	Located In:	Corner Code #
	Mussey Twp.	
	7N 13E	A-13
1. Public Land Survey	T _____ R _____	_____
	T _____ R _____	_____
	T _____ R _____	_____
	T _____ R _____	_____
2. Property Controlling in Section	S _____ T _____ R _____	_____
	S _____ T _____ R _____	<i>Seg 2</i>
3. Miscellaneous Property in Sec.	S _____ T _____ R _____	_____
	S _____ T _____ R _____	_____
4. Lot No. _____, Recorded Plat _____		
5. Private Claims _____		

RECEIVED
1995 AUG -4 AM 10:19
REGISTER OF DEEDS
ST. CLAIR COUNTY, MICHIGAN
Register of Deeds Stamp # File Number

I, Daniel E. Johnson in a field survey on February 9, 1995, do hereby certify that under requirements of P.A. 74, Michigan P.A. of 1970, the corner points mentioned in lines 1 and 2 above were in conformance with regulations and rules therefore as required in the current manual of survey instructions of the United States Department of the Interior, Bureau of Land Management or by a decree of a Court of Law and/or that the corner points mentioned in lines 3, 4 and 5 above were in conformance with the rules of the Michigan Board of Land Surveyors or by a Decree of a Court of Law; established, re-established, monumented, re-monumented, recovered, found as expressed below:

	A	B	C	D	E	F	G	H	I	J	K	L	M
2	6	5	4	3	2								
3													
4	7	8	9	10	11	12							
5													
6	18	17	16	15	14	13							
7													
8	19	20	21	22	23	24							
9													
10	30	29	28	27	26	25							
11													
12	31	32	33	34	35	36							
13													

NOTE: Not more than 1 corner, may be recorded on this certificate.

A. Description of original monument and accessories and/or subsequent restoration:

LIBER 007 PAGE 325


STATE PLAIN COORDINATES

N. _____

E. _____

B. Description of corner evidence found and/or method applied in restoring or reestablishing corner:

LIBER 007 PAGE 325

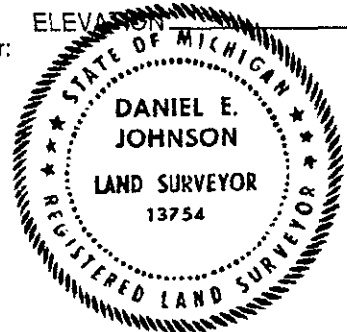

C. Description of monument for corner and accessories established to perpetuate locating the position of the corner:

"ACCEPTED LAPEER COUNTY DISC"

Brass disk stamped Lapeer Co. Remon. M-13 #24608

- 34.83' (34.74'R) NW to a found P.K. with County Tag in W end of 18" C. Spike.
- 44.27' (44.34'R) SW to a found Nail in NW side GTE Pole.
- 64.45' (65.52'R) NE to a found Nail in SW side of P.Pole.
- 46.16' (46.30'R) NE to a found Nail in W face 8" Wood Post.

Signed by *Daniel E. Johnson* Date February 9, 1995
 Daniel E. Johnson
 13754
 Surveyor's Michigan License No. _____

PA 345-1990
PEER COMMITTEE

APPROVED 6-3-94 *Dans*

APPROVED AS AN OFFICIAL GOVERNMENT CORNER BY ST. CLAIR COUNTY:
 Signed By: *Daniel E. Johnson* : 7-31-95 Date
 St. Clair County Land Surveyor Daniel E. Johnson
 13754
 Surveyor's Michigan License No. _____

LIBER 008 PAGE 146