RECEIVED
1994 SEP 20 PM 2:21
REGISTER OF DEEDS
ST. CLAIR COUNTY

# ST. CLAIR COUNTY, MICHIGAN
# OFFICIAL GOVERNMENT CORNER

## LAND CORNER RECORDATION CERTIFICATE
**Filing Requirement of Act 74, Mich. P.A. 1970**

| | | Located In: | Corner Code # |
|---|---|---|---|
| 1. Public Land Survey | | T 7N R 13E | C-13 |
| | | T ___ R ___ | |
| | | T ___ R ___ | |
| | | T ___ R ___ | |
| 2. Property Controlling | S ___ | T ___ R ___ | Seg. 1 |
| in Section | S ___ | T ___ R ___ | |
| 3. Miscellaneous | S ___ | T ___ R ___ | |
| Property in Sec. | S ___ | T ___ R ___ | |

Register of Deeds Stamp & File Number

4. Lot No. _____ , Recorded Plat _____
5. Private Claims _____

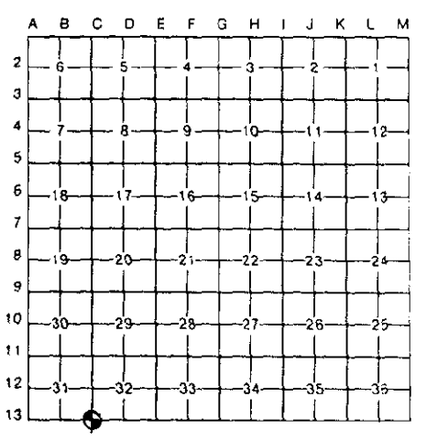


STATE PLAIN COORDINATES

N. _____

E. _____

ELEVATION _____

Michael J. Rossow May 13, 94

I, _____ , in a field survey on _____ , 19 _____ , do hereby certify that under requirements of P.A. 74, Michigan P.A. of 1970, the corner points mentioned in lines 1 and 2 above were in conformance with regulations and rules therefore as required in the current manual of survey instructions of the United States Department of the Interior, Bureau of Land Management or by a decree of a Court of Law and/or that the corner points mentioned in lines 3, 4 and 5 above were in conformance with the rules of the Michigan Board of Land Surveyors or by a Decree of a Court of Law; established, re-established, monumented, re-monumented, recovered, found as expressed below:

**NOTE: Not more than 1 corner, may be recorded on this certificate.**

A. Description of original monument and accessories and/or subsequent restoration:

"Post" set for original corner (Gov't. Survey)

St. Clair Co. Surveyors Record Lists "Gas pipe-Cook"

Act 74 Cert. filed in L.2,P.118 Lists a Railroad Spike as corner.

B. Description of corner evidence found and/or method applied in restoring or reestablishing corner:

Found a Railroad Spike per Act 74 Cert. L.2,P.118 by witnesses shown; N 65° E 28.7 West End N Headwall
S 40° E 43.4 West End S Headwall
S 70° W 180.2 30" Poplar

C. Description of monument for corner and accessories established to perpetuate locating the position of the corner:

Railroad Spike.

137.39' ESE to set P.K. and County Tag in P. Pole.
183.55' ENE to set P.K. and County Tag in P. Pole.
220.32' SSE to set P.K. and County Tag in NW corner barn.
180.31' WSW to set P.K. and County Tag in 24" Cottonwood.

SEE ATTACHED SKETCH FOR ADDITIONAL INFORMATION.

STATE OF MICHIGAN
MICHAEL J. ROSSOW
LAND SURVEYOR
NO 24615
REGISTERED LAND SURVEYOR

Signed by _____ Date May 13, 1994
Michael J. Rossow

Surveyor's Michigan License No. 24615

PA 345-1990
PEER COMM.
APPROVED 6-3-94

APPROVED AS AN OFFICIAL GOVERNMENT CORNER BY ST. CLAIR COUNTY:

Signed By: _____ : _____
St. Clair County Land Surveyor Date

Surveyor's Michigan License No. _____

LIBER 007 PAGE 323

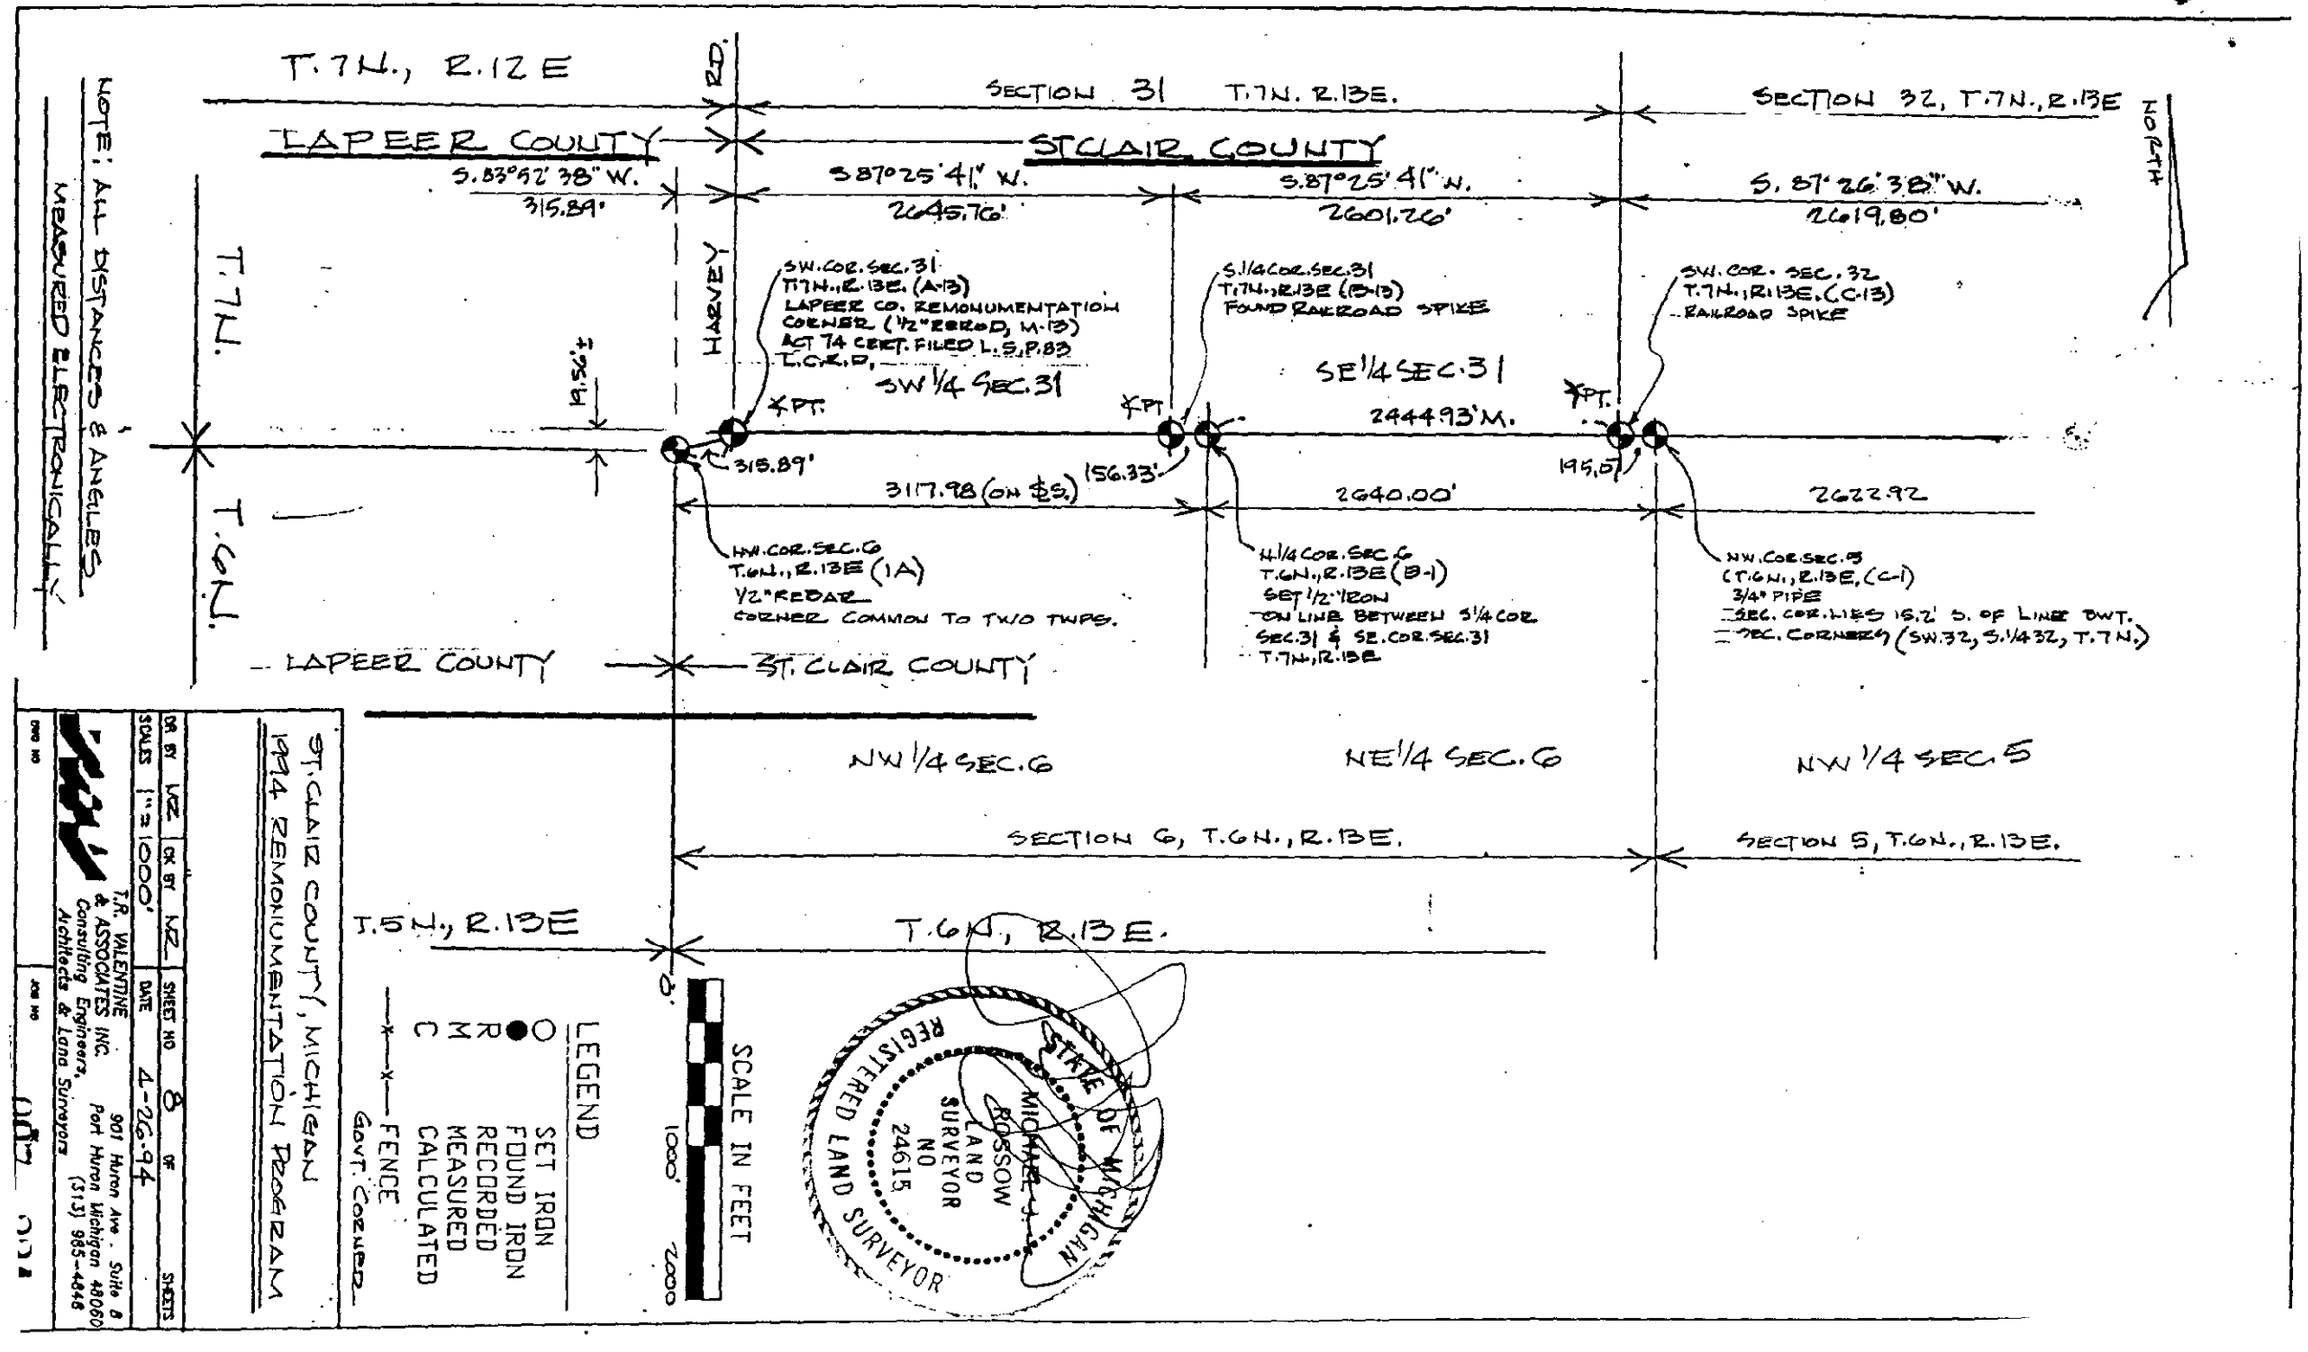


NOTE: ALL DISTANCES & ANGLES MEASURED ELECTRONICALLY

ST. CLAIR COUNTY, MICHIGAN
1994 REMONUMENTATION PROGRAM

| DR BY | CK BY | CK BY | SHEET NO | OF |
|---|---|---|---|---|
| LRZ | LRZ | NRZ | 8 | |
| SCALES | | DATE | | SHEETS |
| 1"=1000' | | 4-26-94 | | |

T.R. VALENTINE & ASSOCIATES INC.
Consulting Engineers, Architects & Land Surveyors
901 Huron Ave., Suite B
Port Huron Michigan 48060
(313) 985-4848

JOB NO

DWG NO