

**ST. CLAIR COUNTY, MICHIGAN
OFFICIAL GOVERNMENT CORNER**



**LAND CORNER RECORDATION CERTIFICATE
Filing Requirement of Act 74, Mich. P.A. 1970**

	Located In:	Corner Code #
	Mussey Twp.	D-13
	7N 13E	
1. Public Land Survey	T _____ R _____	_____
	T _____ R _____	_____
	T _____ R _____	_____
	T _____ R _____	_____
2. Property Controlling in Section	S _____ T _____ R _____	<i>Seg. 2</i>
	S _____ T _____ R _____	_____
3. Miscellaneous Property in Sec.	S _____ T _____ R _____	_____
	S _____ T _____ R _____	_____

RECEIVED
REGISTER OF DEEDS
ST. CLAIR COUNTY
1995 AUG -4 AM 10:20
Register of Deeds Stamp & File Number

4. Lot No. _____, Recorded Plat _____
5. Private Claims _____

A	B	C	D	E	F	G	H	I	J	K	L
2	6	5	4	3	2	1					
3											
4	7	8	9	10	11	12					
5											
6	18	17	16	15	14	13					
7											
8	19	20	21	22	23	24					
9											
10	30	29	28	27	26	25					
11											
12	31	32	33	34	35	36					
13											

I, Daniel E. Johnson, in a field survey on February 9, 1995, do hereby certify that under requirements of P.A. 74, Michigan P.A. of 1970, the corner points mentioned in lines 1 and 2 above were in conformance with regulations and rules therefore as required in the current manual of survey instructions of the United States Department of the Interior, Bureau of Land Management or by a decree of a Court of Law and/or that the corner points mentioned in lines 3, 4 and 5 above were in conformance with the rules of the Michigan Board of Land Surveyors or by a Decree of a Court of Law; established, re-established, monumented, re-monumented, recovered, found as expressed below:

NOTE: Not more than 1 corner, may be recorded on this certificate.

A. Description of original monument and accessories and/or subsequent restoration:

LIBER 007 PAGE 321

STATE PLAIN COORDINATES


N. _____

E. _____

B. Description of corner evidence found and/or method applied in restoring or reestablishing corner:

LIBER 007 PAGE 321

ELEVATION _____

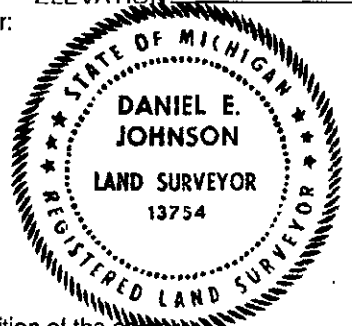

C. Description of monument for corner and accessories established to perpetuate locating the position of the corner:
Set with 2" dia. aluminum cap inscribed "St. Clair County Official Corner" with magnet *on a*

1/2" Rebar and Cap #24615

- 117.07' SE to set P.K. and County Tag in GTE Pole.
- 155.54' E to set P.K. and County Tag in Guard Rail Post.
- 34.94' N to set P.K. and County Tag in FE Post.
- 149.36' WNW to set P.K. and County Tag in 8" Elm.

Signed by Daniel E. Johnson Date February 9, 1995
Daniel E. Johnson
Surveyor's Michigan License No. 13754

PA 345-1990
PEER COMMITTEE

APPROVED AS AN OFFICIAL GOVERNMENT CORNER BY ST. CLAIR COUNTY:

Signed By: Daniel E. Johnson : 7-31-95
St. Clair County Land Surveyor Daniel E. Johnson
13754 Date _____
Surveyor's Michigan License No. _____

APPROVED 6-3-94
Don J
LIBER 008 PAGE 149