ST. CLAIR COUNTY, MICHIGAN
OFFICIAL GOVERNMENT CORNER

LAND CORNER RECORDATION CERTIFICATE
Filing Requirement of Act 74, Mich. P.A. 1970

SAINT CLAIR COUNTY 1820 MICHIGAN

RECEIVED
AUG -4 AM 10: 20
REGISTER OF DEEDS
ST. CLAIR COUNTY

		Located In: Mussey Twp. 7N 13E	Corner Code # E-13
1. Public Land Survey		T ____ R ____	
		T ____ R ____	
		T ____ R ____	
		T ____ R ____	
2. Property Controlling	S ____	T ____ R ____	Seg. 2
in Section	S ____	T ____ R ____	
3. Miscellaneous	S ____	T ____ R ____	
Property in Sec.	S ____	T ____ R ____	

Register of Deeds Stamp & File Number

4. Lot No. _____ , Recorded Plat _____
5. Private Claims _____

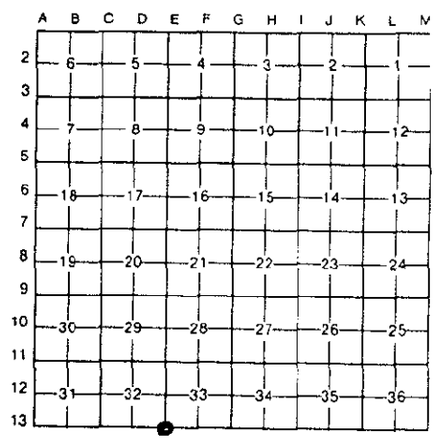

I, Daniel E. Johnson, in a field survey on February 9, 19 95, do hereby certify that under requirements of P.A. 74, Michigan P.A. of 1970, the corner points mentioned in lines 1 and 2 above were in conformance with regulations and rules therefore as required in the current manual of survey instructions of the United States Department of the Interior, Bureau of Land Management or by a decree of a Court of Law and/or that the corner points mentioned in lines 3, 4 and 5 above were in conformance with the rules of the Michigan Board of Land Surveyors or by a Decree of a Court of Law, established, re-established, monumented, re-monumented, recovered, found as expressed below:

NOTE: Not more than 1 corner, may be recorded on this certificate.

A. Description of original monument and accessories and/or subsequent restoration:

LIBER 007 PAGE 319

STATE PLAIN COORDINATES

N. _____

E. _____

ELEVATION _____

B. Description of corner evidence found and/or method applied in restoring or reestablishing corner:

LIBER 007 PAGE 319

STATE OF MICHIGAN
DANIEL E. JOHNSON
LAND SURVEYOR
13754
REGISTERED LAND SURVEYOR

C. Description of monument for corner and accessories established to perpetuate locating the position of the corner:

Set with 2" dia. aluminum cap inscribed "St. Clair County Official Corner" with magnet on a

1/2" Iron.

109.75'	NNE	to set P.K. and County Tag in 36" Oak.
49.07'	SSW	to set P.K. and County Tag in 12" Apple.
130.61'	SE	to set P.K. and County Tag in 12" Pear.
108.35'	NW	to set P.K. and County Tag in P. Pole.
23.13'	S	State Control Monument #74019 1977.

Signed by Daniel E. Johnson Date February 9, 1995

Daniel E. Johnson
13754

Surveyor's Michigan License No. _____

PA 345-1990
PEER COMMITTEE
APPROVED 6-3-94

APPROVED AS AN OFFICIAL GOVERNMENT CORNER BY ST. CLAIR COUNTY:

Signed By: Daniel E. Johnson : 7-31-95

St. Clair County Land Surveyor Daniel E. Johnson Date

13754

Surveyor's Michigan License No. _____

LIBER 008 PAGE 150