
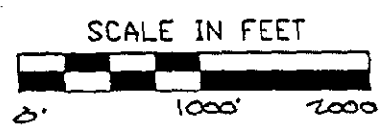
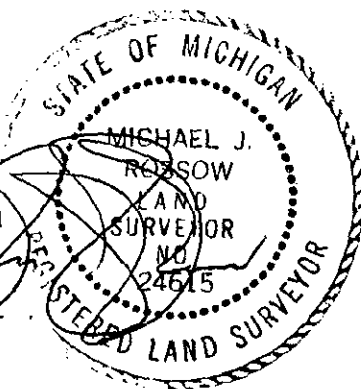


SECTION 33, T.7N., R.13E. SECTION 34 T.7N., R.13E. SECTION 35, T.7N., R.13E.

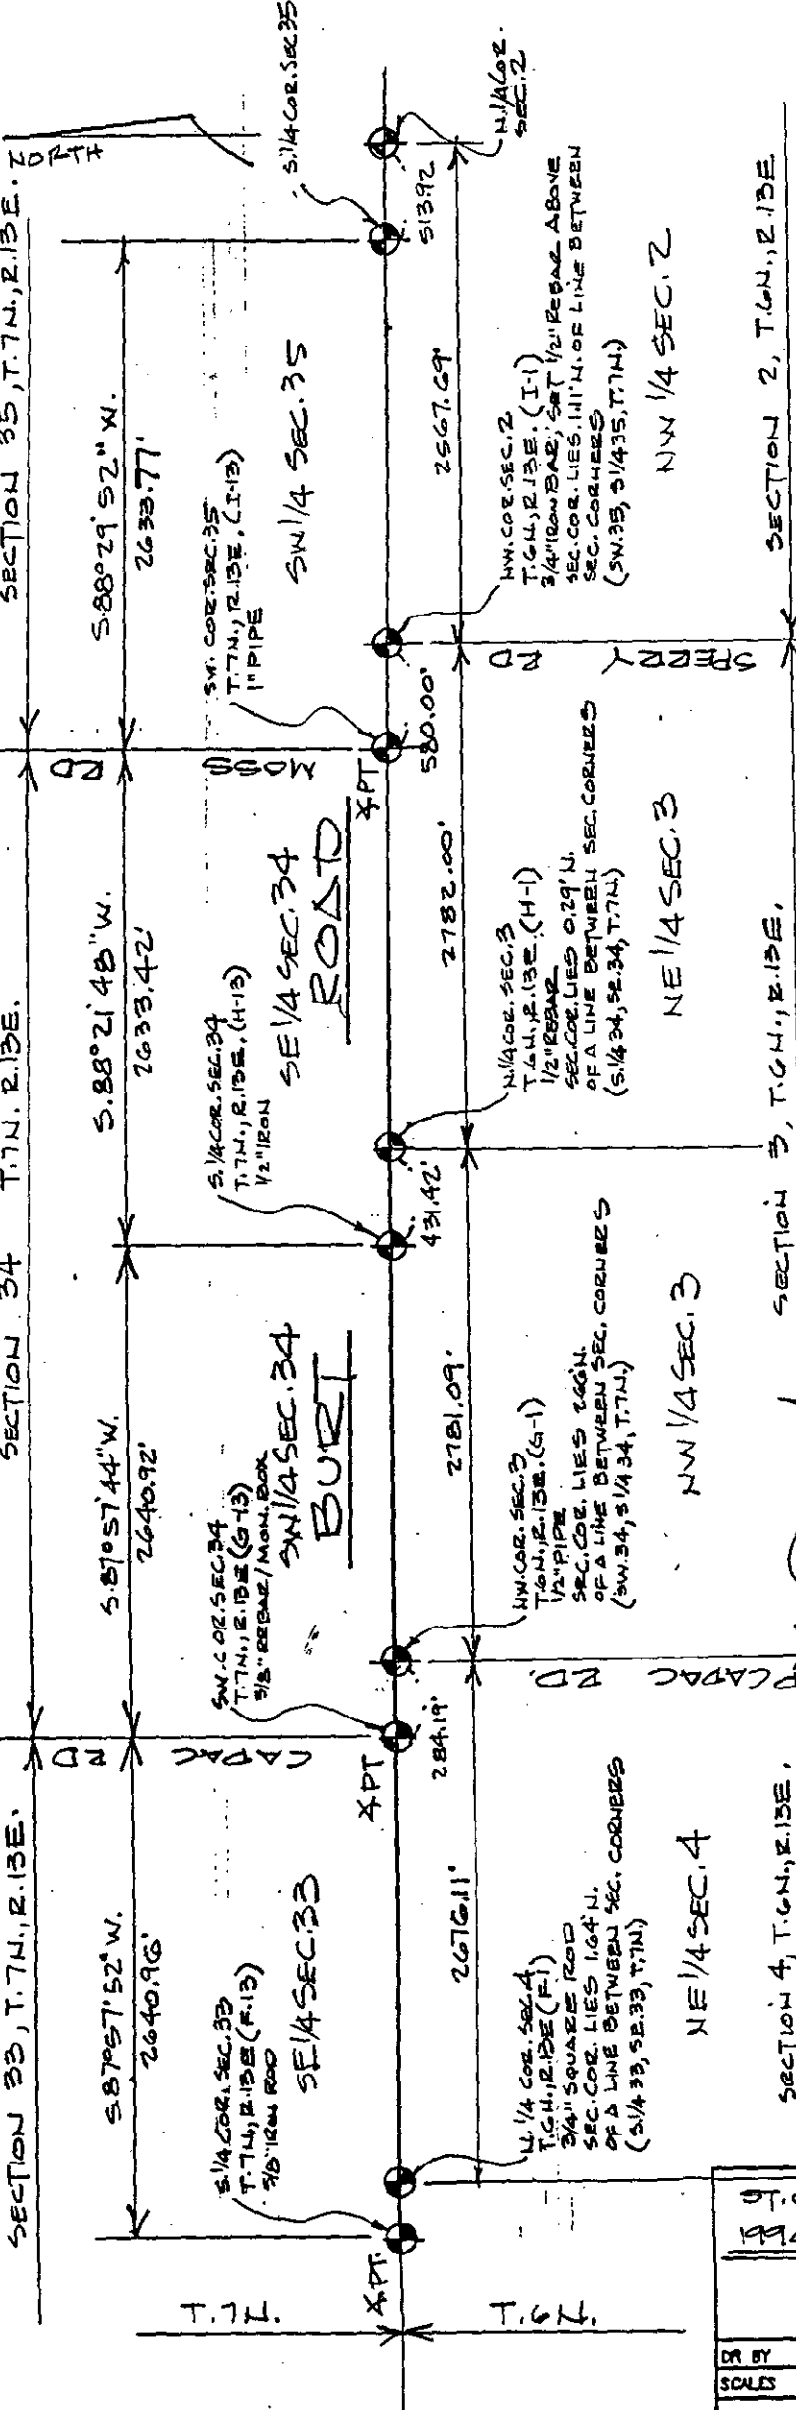

LEGEND

○	SET IRON
●	FOUND IRON
○	RECORDED
○	MEASURED
○	CALCULATED
—x—x—	FENCE
—x—x—	GOVT. CORNER

ST. CLAIR COUNTY, MICHIGAN
1994 REMONUMENTATION PROGRAM

DR BY NZ CK BY NZ SHEET NO. 6 OF SHEETS
SCALE "1" = 1000' DATE 4-26-94

J.V. T.R. VALENTINE & ASSOCIATES INC. 901 Huron Ave., Suite B
Consulting Engineers, Port Huron Michigan 48060
Architects & Land Surveyors (313) 985-4348

DWG NO. _____ JOB NO. LIBER 007 PAGE 314

NOTE: ALL DISTANCES & ANGLES
MEASURED ELECTRONICALLY