

# ST. CLAIR COUNTY, MICHIGAN OFFICIAL GOVERNMENT CORNER



## LAND CORNER RECORDATION CERTIFICATE Filing Requirement of Act 74, Mich. P.A. 1970

	Located In:	Corner Code #
	<b>Mussey Twp.</b>	
	<b>7N 13E</b>	<b>H-13</b>
1. Public Land Survey	T _____ R _____	_____
	T _____ R _____	_____
	T _____ R _____	_____
	T _____ R _____	_____
2. Property Controlling in Section	S _____ T _____ R _____	<i>Sec 2</i>
	S _____ T _____ R _____	_____
3. Miscellaneous Property in Sec.	S _____ T _____ R _____	_____
	S _____ T _____ R _____	_____
4. Lot No. _____, Recorded Plat _____		
5. Private Claims _____		

RECEIVED  
REGISTER OF DEEDS  
ST. CLAIR COUNTY, MICHIGAN  
1995 AUG -4 AM 10:00  
Register of Deeds Stamp & File Number

I, **Daniel E. Johnson**, in a field survey on **February 9,** 19**95**, do hereby certify that under requirements of P.A. 74, Michigan P.A. of 1970, the corner points mentioned in lines 1 and 2 above were in conformance with regulations and rules therefore as required in the current manual of survey instructions of the United States Department of the Interior, Bureau of Land Management or by a decree of a Court of Law and/or that the corner points mentioned in lines 3, 4 and 5 above were in conformance with the rules of the Michigan Board of Land Surveyors or by a Decree of a Court of Law; established, re-established, monumented, re-monumented, recovered, found as expressed below:

	A	B	C	D	E	F	G	H	I	J	K	L	M
2	6	5	4	3	2	1							
3													
4	7	8	9	10	11	12							
5													
6	18	17	16	15	14	13							
7													
8	19	20	21	22	23	24							
9													
10	30	29	28	27	26	25							
11													
12	31	32	33	34	35	36							
13													

**NOTE: Not more than 1 corner, may be recorded on this certificate.**

A. Description of original monument and accessories and/or subsequent restoration:

LIBER 007 PAGE 313

STATE PLAIN COORDINATES


N. \_\_\_\_\_

E. \_\_\_\_\_

B. Description of corner evidence found and/or method applied in restoring or reestablishing corner:

LIBER 007 PAGE 313

ELEVATION \_\_\_\_\_

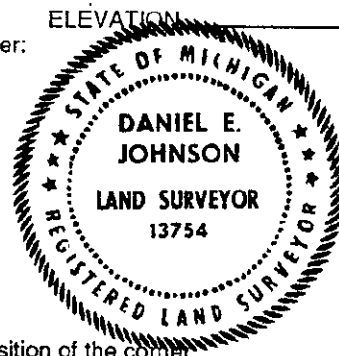

C. Description of monument for corner and accessories established to perpetuate locating the position of the corner:

Set with 2" dia. aluminum cap inscribed "St. Clair County Official Corner" with magnet *on a*

1/2" Iron.

- 57.40' SW to set P.K. and County Tag in P. Pole.
- 62.32' SSE to set P.K. and County Tag in 18" Oak.
- 166.74' NNW to set P.K. and County Tag in P. Pole.
- 162.07' ENE to set P.K. and County Tag in GTE Pole.

Signed by *Daniel E. Johnson* Date February 9, 1995  
Daniel E. Johnson  
13754

Surveyor's Michigan License No. \_\_\_\_\_

PA 345-1990  
PEER COMMITTEE

APPROVED AS AN OFFICIAL GOVERNMENT CORNER BY ST. CLAIR COUNTY:

Signed By: *Daniel E. Johnson* : 7-31-95  
St. Clair County Land Surveyor Daniel E. Johnson  
13754

Surveyor's Michigan License No. \_\_\_\_\_

APPROVED 6-3-94

Date

008 PAGE 153