

ST. CLAIR COUNTY, MICHIGAN OFFICIAL GOVERNMENT CORNER



LAND CORNER RECORDATION CERTIFICATE Filing Requirement of Act 74, Mich. P.A. 1970

RECEIVED
 REGISTER OF DEEDS
 ST. CLAIR COUNTY
 1995 AUG -4 AM 10: 20

	Located In:	Corner Code #	
	Mussey Twp.		
	7N 13E	I-13	
1. Public Land Survey	T _____ R _____	_____	_____
	T _____ R _____	_____	_____
	T _____ R _____	_____	_____
	T _____ R _____	_____	_____
2. Property Controlling in Section	S _____ T _____ R _____	<i>Seg 2</i>	_____
	S _____ T _____ R _____	_____	_____
3. Miscellaneous Property in Sec.	S _____ T _____ R _____	_____	_____
	S _____ T _____ R _____	_____	_____

Register of Deeds Stamp & File Number

4. Lot No. _____, Recorded Plat _____
 5. Private Claims _____

	A	B	C	D	E	F	G	H	I	J	K	L	M
2	6	5	4	3	2	1							
3													
4	7	8	9	10	11	12							
5													
6	18	17	16	15	14	13							
7													
8	19	20	21	22	23	24							
9													
10	30	29	28	27	26	25							
11													
12	31	32	33	34	35	36							
13													

I, **Daniel E. Johnson**, in a field survey on **February 9,** 19**95**, do hereby certify that under requirements of P.A. 74, Michigan P.A. of 1970, the corner points mentioned in lines 1 and 2 above were in conformance with regulations and rules therefore as required in the current manual of survey instructions of the United States Department of the Interior, Bureau of Land Management or by a decree of a Court of Law and/or that the corner points mentioned in lines 3, 4 and 5 above were in conformance with the rules of the Michigan Board of Land Surveyors or by a Decree of a Court of Law; established, re-established, monumented, re-monumented, recovered, found as expressed below:

NOTE: Not more than 1 corner, may be recorded on this certificate.

A. Description of original monument and accessories and/or subsequent restoration:


LIBER 007 PAGE 311

STATE PLAIN COORDINATES

N. _____
 E. _____

B. Description of corner evidence found and/or method applied in restoring or reestablishing corner:

LIBER 007 PAGE 311

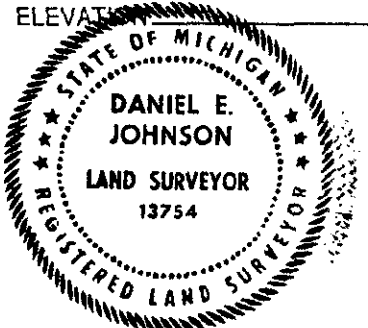

C. Description of monument for corner and accessories established to perpetuate locating the position of the corner:
 Set 1/2" x 18" Rerod with 2" dia. aluminum cap inscribed "St. Clair County Official Corner" with magnet.

- 63.02' NW to P.K. and County Tag in Underground Tele Support Post. (above MDSH Tag).
- 102.07' NNW to P.K. and County Tag in P. Pole.
- 171.46' NE to P.K. and County Tag Below F.P.K.
- 249.38' SE to P.K. and County Tag Corner FE.Post (FE's S & W)
- 33.95' SSE to Centerline MDOT Monument with brass disk stamped #77013 1977.

Signed by *Daniel E. Johnson* Date February 9, 1995
 Daniel E. Johnson
 Surveyor's Michigan License No. 13754

PA 345-1990
 PEER COMMITTEE

APPROVED AS AN OFFICIAL GOVERNMENT CORNER BY ST. CLAIR COUNTY:

Signed By: *Daniel E. Johnson* : 7-31-95 Date _____
 St. Clair County Land Surveyor Daniel E. Johnson
 13754

LIBER 008 PAGE 154