

RECEIVED
REGISTER OF DEEDS

1994 SEP 20 PM 2:21

REGISTER OF DEEDS
ST. CLAIR COUNTY

ST. CLAIR COUNTY, MICHIGAN OFFICIAL GOVERNMENT CORNER



LAND CORNER RECORDATION CERTIFICATE
Filing Requirement of Act 74, Mich. P.A. 1970

Located In: Corner Code ##

| | | | | | |
|------------------------------------|---|-----------|---|------------|---------------|
| 1. Public Land Survey | T | <u>7N</u> | R | <u>13E</u> | <u>L-13</u> |
| | T | | R | | |
| | T | | R | | |
| | T | | R | | |
| 2. Property Controlling in Section | S | | T | | <u>Sec. 1</u> |
| | S | | T | | |
| 3. Miscellaneous Property in Sec. | S | | T | | |
| | S | | T | | |

Register of Deeds Stamp & File Number

4. Lot No. _____, Recorded Plat _____
5. Private Claims _____

Michael J. Rossow February 5, 94

I, _____, in a field survey on _____, 19 _____, do hereby certify that under requirements of P.A. 74, Michigan P.A. of 1970, the corner points mentioned in lines 1 and 2 above were in conformance with regulations and rules therefore as required in the current manual of survey instructions of the United States Department of the Interior, Bureau of Land Management or by a decree of a Court of Law and/or that the corner points mentioned in lines 3, 4 and 5 above were in conformance with the rules of the Michigan Board of Land Surveyors or by a Decree of a Court of Law; established, re-established, monumented, re-monumented, recovered, found as expressed below:

| A | B | C | D | E | F | G | H | I | J | K | L | M |
|----|----|----|----|----|----|----|---|---|---|---|---|---|
| 2 | 6 | 5 | 4 | 3 | 2 | 1 | | | | | | |
| 3 | | | | | | | | | | | | |
| 4 | 7 | 8 | 9 | 10 | 11 | 12 | | | | | | |
| 5 | | | | | | | | | | | | |
| 6 | 18 | 17 | 16 | 15 | 14 | 13 | | | | | | |
| 7 | | | | | | | | | | | | |
| 8 | 19 | 20 | 21 | 22 | 23 | 24 | | | | | | |
| 9 | | | | | | | | | | | | |
| 10 | 30 | 29 | 28 | 27 | 26 | 25 | | | | | | |
| 11 | | | | | | | | | | | | |
| 12 | 31 | 32 | 33 | 34 | 35 | 36 | | | | | | |
| 13 | | | | | | | | | | | | |

NOTE: Not more than 1 corner, may be recorded on this certificate.

A. Description of original monument and accessories and/or subsequent restoration:

"Post" set for original corner. (Gov't. Survey)
St. Clair Co. Surveyors Record indicated as corner existed in the 1930's with witnesses, but does not identify corner.
Act 74 Cert. filed L.4,P.31 calls for 5/8" Rod with 1 1/2" brass disk (MDOT). L.4,P.110 calls for 3/4" Iron pipe.


STATE PLAIN COORDINATES
N. _____
E. _____
ELEVATION _____

B. Description of corner evidence found and/or method applied in restoring or reestablishing corner:

Found 3/4" pipe per Cert. filed in L.4,P.31 and L.4,P.110. and in agreement with Act 132 Cert. filed L.11,P.286.

C. Description of monument for corner and accessories established to perpetuate locating the position of the corner:

3/4" pipe.
90.17' NW to set P.K. and County Tag in P. Pole.
328.90' ENE to set P.K. and County Tag in P. Pole.
449.82' NNE to set P.K. and County Tag in Corner FE Post. (FE.E & N).
486.21' NNW to set P.K. and County Tag in P. Pole.

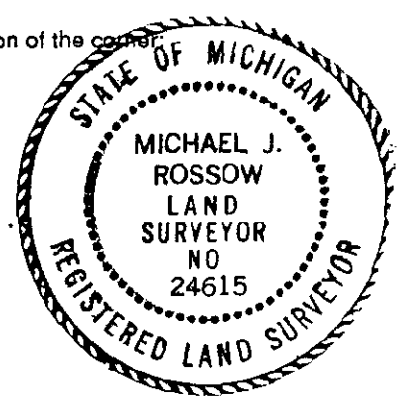

SEE ATTACHED SKETCH FOR ADDITIONAL INFORMATION.

Signed by Michael J. Rossow PA 345-1990 Date May 13, 1994
Surveyor's Michigan License No. 24615 PEER COMMITTEE
APPROVED 6-10-94

APPROVED AS AN OFFICIAL GOVERNMENT CORNER BY ST. CLAIR COUNTY:

Signed By: _____ Date _____
St. Clair County Land Surveyor

Surveyor's Michigan License No. _____

LIBER 007 PAGE 305

