


NOTE: ALL DISTANCES & ANGLES MEASURED ELECTRONICALLY

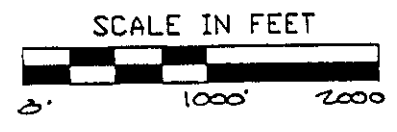

LEGEND

○	SET IRON
●	FOUND IRON
○	RECORDED
○	MEASURED
○	CALCULATED
—x—x—	FENCE
○	GOVT. CORNER

ST. CLAIR COUNTY, MICHIGAN			
1994 REIMONUMENTATION PROGRAM			
DR BY	MZ	CK BY	MZ
SHEET NO 5		OF SHEETS	
SCALE 1" = 1000'		DATE 4-26-94	
T.R. VALENTINE & ASSOCIATES INC.		901 Huron Ave., Suite 6	
Consulting Engineers, Architects & Land Surveyors		Port Huron Michigan 48060	
		(313) 985-4848	
JOB NO		JOB NO 007	
TIRFR		PAGE 304	