

ST. CLAIR COUNTY, MICHIGAN OFFICIAL GOVERNMENT CORNER



LAND CORNER RECORDATION CERTIFICATE Filing Requirement of Act 74, Mich. P.A. 1970

	Located In:	Corner Code #	
	Mussey Twp.		
	7N 13E	M-13	
1. Public Land Survey	T _____ R _____	_____	_____
	T _____ R _____	_____	_____
	T _____ R _____	_____	_____
	T _____ R _____	_____	_____
2. Property Controlling in Section	S _____ T _____ R _____	<i>Sec. 2</i>	
	S _____ T _____ R _____	_____	_____
3. Miscellaneous Property in Sec.	S _____ T _____ R _____	_____	_____
	S _____ T _____ R _____	_____	_____

RECEIVED
 1995 AUG -4 AM 10: 21
 REGISTER OF DEEDS
 ST. CLAIR COUNTY

Register of Deeds Stamp & File Number

4. Lot No. _____, Recorded Plat _____
 5. Private Claims _____

I, Daniel E. Johnson February 7, 1995
 in a field survey on _____, do hereby certify that under requirements of P.A. 74, Michigan P.A. of 1970, the corner points mentioned in lines 1 and 2 above were in conformance with regulations and rules therefore as required in the current manual of survey instructions of the United States Department of the Interior, Bureau of Land Management or by a decree of a Court of Law and/or that the corner points mentioned in lines 3, 4 and 5 above were in conformance with the rules of the Michigan Board of Land Surveyors or by a Decree of a Court of Law, established, re-established, monumented, re-monumented, recovered, found as expressed below:

	A	B	C	D	E	F	G	H	I	J	K	L	M
2	6	5	4	3	2	1							
3													
4	7	8	9	10	11	12							
5													
6	18	17	16	15	14	13							
7													
8	19	20	21	22	23	24							
9													
10	30	29	28	27	26	25							
11													
12	31	32	33	34	35	36							
13													

NOTE: Not more than 1 corner, may be recorded on this certificate.

A. Description of original monument and accessories and/or subsequent restoration:

LIBER 007 PAGE 303


STATE PLAIN COORDINATES

N. _____

E. _____

B. Description of corner evidence found and/or method applied in restoring or reestablishing corner:

LIBER 007 PAGE 303

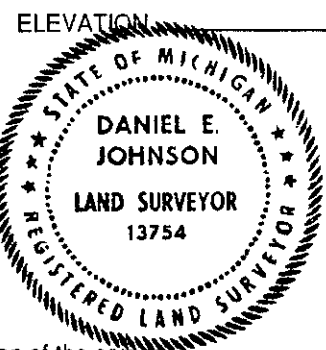

C. Description of monument for corner and accessories established to perpetuate locating the position of the corner:

"ACCEPTED MICHIGAN DEPARTMENT OF TRANSPORTATION BRASS DISC"

1 1/2" brass disc on 5/8" rod.

- 73.81' WNW to set P.K. and County Tag in 15" Elm.
- 75.07' NW to set P.K. and County Tag in P.Pole (set above MDOT Tag).
- 83.52' NE to set P.K. and County Tag in P.Pole (set above prev. P.K.).
- 272.31' ESE to set P.K. and County Tag in P.Pole.
- 17.05' E County Road PI to North.

Signed by *Daniel E. Johnson* Date February 7, 1995
 Daniel E. Johnson
 13754

Surveyor's Michigan License No. _____

PA 345-1990
PEER COMMITTEE

APPROVED AS AN OFFICIAL GOVERNMENT CORNER BY ST. CLAIR COUNTY:

Signed By: *Daniel E. Johnson* : 7-31-95
 Daniel E. Johnson
 13754

Surveyor's Michigan License No. _____

Date
LIBER 008 PAGE 158