
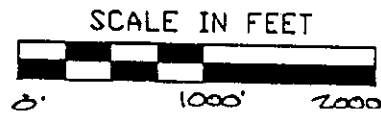


NOTE: ALL DISTANCES & ANGLES
MEASURED ELECTRONICALLY

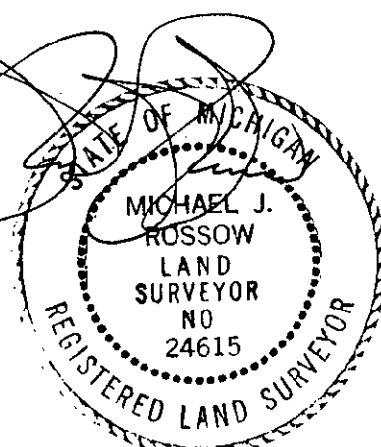

LEGEND

○	SET IRON
●	FOUND IRON
○	RECORDED
○	MEASURED
○	CALCULATED
—x—x—	FENCE
○	GOVT. CORNER

ST. CLAIR COUNTY, MICHIGAN
1994 REMONUMENTATION PROGRAM

DR BY	MZ	CK BY	MZ	SHEET NO	4	OF	SHEETS
SCALES	1" = 1000'	DATE	4-26-94				

T.R. VALENTINE & ASSOCIATES INC.
901 Huron Ave., Suite B
Port Huron Michigan 48060
Consulting Engineers, (313) 985-4848
Architects & Land Surveyors