

ST. CLAIR COUNTY, MICHIGAN OFFICIAL GOVERNMENT CORNER



LAND CORNER RECORDATION CERTIFICATE Filing Requirement of Act 74, Mich. P.A. 1970

RECEIVED
 REGISTER OF DEEDS
 ST. CLAIR COUNTY
 1995 JUN -4 11 10:14

Register of Deeds Stamp & File Number

	Located In:	Corner Code #	
1. Public Land Survey	T <u>7N</u> R <u>14E</u>	-- F-13	_____
	T _____ R _____	_____	_____
	T _____ R _____	_____	_____
	T _____ R _____	_____	_____
2. Property Controlling in Section	S _____ T _____ R _____	<u>Sec 2</u>	_____
	S _____ T _____ R _____	_____	_____
3. Miscellaneous Property in Sec.	S _____ T _____ R _____	_____	_____
	S _____ T _____ R _____	_____	_____

4. Lot No. _____, Recorded Plat _____
 5. Private Claims _____

I, Daniel E. Johnson, in a field survey on May 22, 19 95, do hereby certify that under requirements of P.A. 74, Michigan P.A. of 1970, the corner points mentioned in lines 1 and 2 above were in conformance with regulations and rules therefore as required in the current manual of survey instructions of the United States Department of the Interior, Bureau of Land Management or by a decree of a Court of Law and/or that the corner points mentioned in lines 3, 4 and 5 above were in conformance with the rules of the Michigan Board of Land Surveyors or by a Decree of a Court of Law; established, re-established, monumented, re-monumented, recovered, found as expressed below:

NOTE: Not more than 1 corner, may be recorded on this certificate.

A. Description of original monument and accessories and/or subsequent restoration:

LIBER 007 PAGE 339

B. Description of corner evidence found and/or method applied in restoring or reestablishing corner:

LIBER 007 PAGE 339

C. Description of monument for corner and accessories established to perpetuate locating the position of the corner:

Set 1/2" x 18" Rebar inside with 2" Dia. Aluminum Cap inscribed "St. Clair County Official Corner" with magnet over 1 1/4" pipe.

- 51.58' SSW to set P.K. and County Tag in P.Pole.
- 92.33' N to set P.K. and County Tag in 10" Apple
- 394.96' ESE to set P.K. and County Tag in P.Pole
- 551.48' WNW to set P.K. and County Tag in P.Pole

Signed by Daniel E. Johnson Date May 22, 1995
Daniel E. Johnson

Surveyor's Michigan License No. 13754

PA 345-1990
PEER COMMITTEE

APPROVED AS AN OFFICIAL GOVERNMENT CORNER BY ST. CLAIR COUNTY:

Signed By: Daniel E. Johnson Date 7-31-95
St. Clair County Land Surveyor Daniel E. Johnson

Surveyor's Michigan License No. 13754

LIBER 008 PAGE 99


	A	B	C	D	E	F	G	H	I	J	K	L	M
2	6	5	4	3	2	1							
3													
4	7	8	9	10	11	12							
5													
6	18	17	16	15	14	13							
7													
8	19	20	21	22	23	24							
9													
10	30	29	28	27	26	25							
11													
12	31	32	33	34	35	36							
13													

STATE PLAIN COORDINATES

N. _____

E. _____

ELEVATION _____

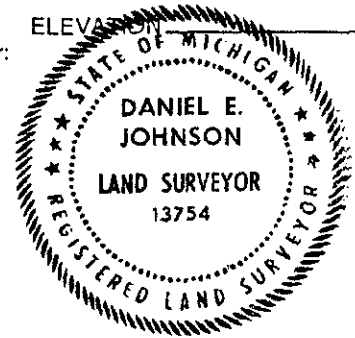

APPROVED 5-20-94 *Dan*