
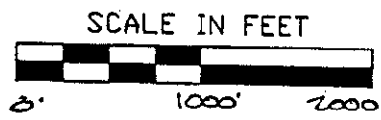
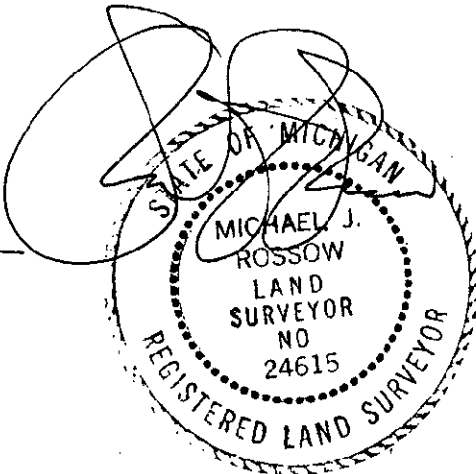


HORTH

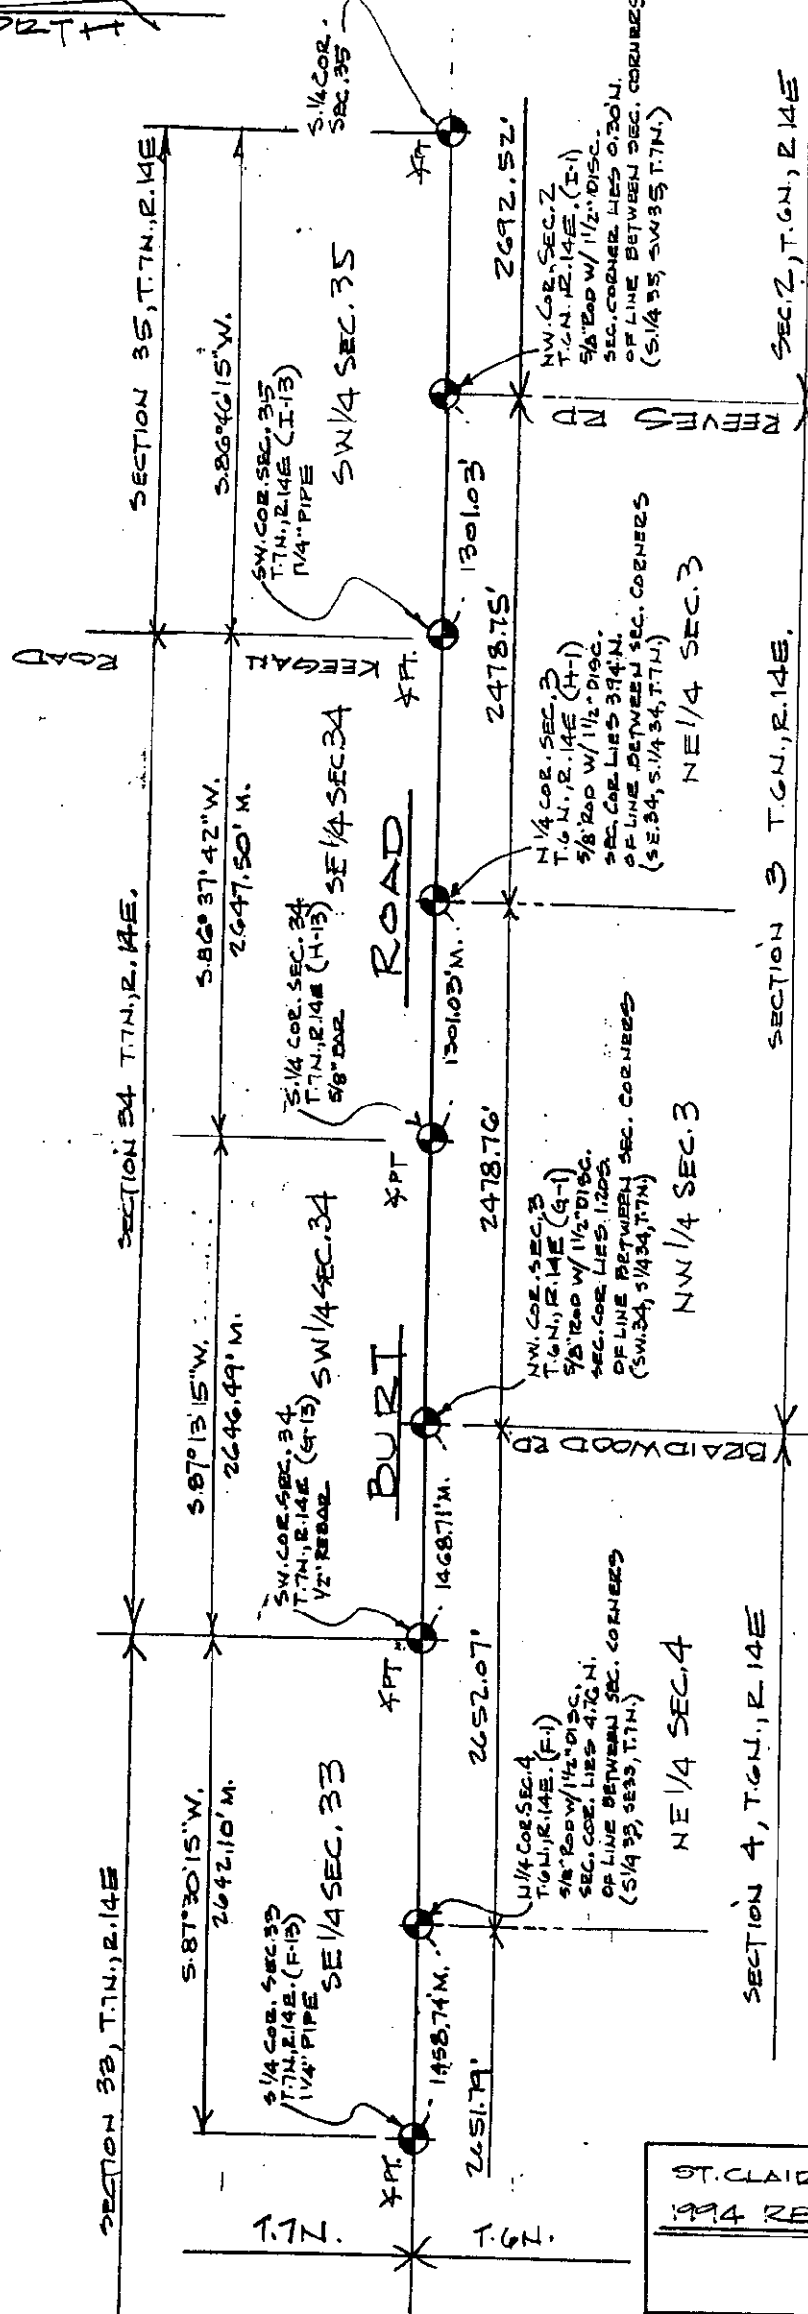

LEGEND

- SET IRON
- FOUND IRON
- RECORDED
- MEASURED
- CALCULATED
- x — FENCE
- x — GOVT. CORNER

ST. CLAIR COUNTY, MICHIGAN
1994 REMONUMENTATION PROGRAM

DR BY	MZ	CR BY	MZ	SHEET NO	3	OF	SHEETS
SCALES		1" = 1000'		DATE		4-26-94	

T.R. VALENTINE & ASSOCIATES INC. 901 Huron Ave., Suite 8
 Consulting Engineers, Port Huron Michigan 48060 (313) 985-4848
 Architects & Land Surveyors

NOTE: ALL DISTANCES & ANGLES
MEASURED ELECTRONICALLY