

# ST. CLAIR COUNTY, MICHIGAN OFFICIAL GOVERNMENT CORNER



## LAND CORNER RECORDATION CERTIFICATE Filing Requirement of Act 74, Mich. P.A. 1970

RECEIVED  
 ST. CLAIR COUNTY  
 REGISTER OF DEEDS  
 5/13-4 11:10:15

Located In: Emmett Twp. Corner Code # \_\_\_\_\_

- |                                    |              |               |         |              |
|------------------------------------|--------------|---------------|---------|--------------|
| 1. Public Land Survey              | T <u>7N.</u> | R <u>14E.</u> | M-13    |              |
|                                    | T _____      | R _____       | _____   | _____        |
|                                    | T _____      | R _____       | _____   | _____        |
|                                    | T _____      | R _____       | _____   | _____        |
| 2. Property Controlling in Section | S _____      | T _____       | R _____ | <i>Seg 2</i> |
|                                    | S _____      | T _____       | R _____ |              |
|                                    | S _____      | T _____       | R _____ |              |
| 3. Miscellaneous Property in Sec.  | S _____      | T _____       | R _____ | _____        |

Register of Deeds Stamp & File Number

4. Lot No. \_\_\_\_\_, Recorded Plat \_\_\_\_\_
5. Private Claims \_\_\_\_\_

	A	B	C	D	E	F	G	H	I	J	K	L	M
2	6		5		4		3		2		1		
3													
4	7		8		9		10		11		12		
5													
6	18		17		16		15		14		13		
7													
8	19		20		21		22		23		24		
9													
10	30		29		28		27		26		25		
11													
12	31		32		33		34		35		36		
13													

I, Daniel E. Johnson, in a field survey on May 25, 1995 do hereby certify that under requirements of P.A. 74, Michigan P.A. of 1970, the corner points mentioned in lines 1 and 2 above were in conformance with regulations and rules therefore as required in the current manual of survey instructions of the United States Department of the Interior, Bureau of Land Management or by a decree of a Court of Law and/or that the corner points mentioned in lines 3, 4 and 5 above were in conformance with the rules of the Michigan Board of Land Surveyors or by a Decree of a Court of Law; established, re-established, monumented, re-monumented, recovered, found as expressed below:

**NOTE: Not more than 1 corner, may be recorded on this certificate.**

A. Description of original monument and accessories and/or subsequent restoration:

**LIBER 007 PAGE 189**

STATE PLAIN COORDINATES


N. \_\_\_\_\_

E. \_\_\_\_\_

ELEVATION \_\_\_\_\_

B. Description of corner evidence found and/or method applied in restoring or reestablishing corner:

**LIBER 007 PAGE 189**

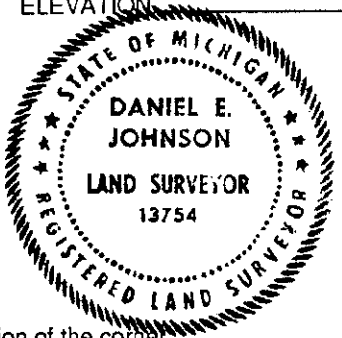

C. Description of monument for corner and accessories established to perpetuate locating the position of the corner.  
Set with 2" dia. aluminum cap inscribed "St. Clair County Official Corner" with magnet.

- E. 29.15' to set PK and County Tag in N face of 48" Maple
- NE 42.83' to set PK and County Tag in W face of 12" Maple
- NW 54.37' to set PK and County Tag in S face of twin 15" Poplar
- S. 33.35' to set PK and County Tag in N face of twin 12" Maple

Signed by *Daniel E. Johnson* Date MAY 25, 1995  
 Daniel E. Johnson

Surveyor's Michigan License No. 13754 PA 345-1990 PEER COMMITTEE

APPROVED AS AN OFFICIAL GOVERNMENT CORNER BY ST. CLAIR COUNTY:

Signed By: *Daniel E. Johnson* Date 7-31-95

St. Clair County Land Surveyor Daniel E. Johnson  
 13754

Surveyor's Michigan License No. \_\_\_\_\_ LIBER 008 PAGE 106