

ST. CLAIR COUNTY, MICHIGAN OFFICIAL GOVERNMENT CORNER



LAND CORNER RECORDATION CERTIFICATE Filing Requirement of Act 74, Mich. P.A. 1970

Located In: Corner Code #

1. Public Land Survey	T <u>7N</u> R <u>14E</u>	— <u>H-13</u> —	
	T — R —	— —	
	T — R —	— —	
	T — R —	— —	
2. Property Controlling in Section	S — T — R —		<i>Sec 2</i>
	S — T — R —		
	S — T — R —		
3. Miscellaneous Property in Sec.	S — T — R —		

RECEIVED
REGISTER OF DEEDS
ST. CLAIR COUNTY
1995 AUG - 4 AM 10:14
Register of Deeds Stamp File Number

4. Lot No. _____, Recorded Plat _____
5. Private Claims _____

	A	B	C	D	E	F	G	H	I	J	K	L	M
2	6	5	4	3	2	1							
3													
4	7	8	9	10	11	12							
5													
6	18	17	16	15	14	13							
7													
8	19	20	21	22	23	24							
9													
10	30	29	28	27	26	25							
11													
12	31	32	33	34	35	36							
13													

I, Daniel E. Johnson, in a field survey on May 22, 19 95, do hereby certify that under requirements of P.A. 74, Michigan P.A. of 1970, the corner points mentioned in lines 1 and 2 above were in conformance with regulations and rules therefore as required in the current manual of survey instructions of the United States Department of the Interior, Bureau of Land Management or by a decree of a Court of Law and/or that the corner points mentioned in lines 3, 4 and 5 above were in conformance with the rules of the Michigan Board of Land Surveyors or by a Decree of a Court of Law; established, re-established, monumented, re-monumented, recovered, found as expressed below:

NOTE: Not more than 1 corner, may be recorded on this certificate.

A. Description of original monument and accessories and/or subsequent restoration:

LIBER 007 PAGE 335

STATE PLAIN COORDINATES


N. _____

E. _____

ELEVATION _____

B. Description of corner evidence found and/or method applied in restoring or reestablishing corner:

LIBER 007 PAGE 335

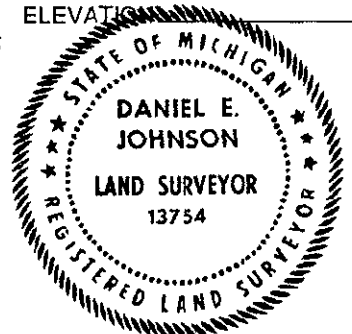

C. Description of monument for corner and accessories established to perpetuate locating the position of the corner:

Set 1/2" x 18" Rebar with 2" Dia. Aluminum Cap inscribed "St. Clair County Official Corner" with magnet over 5/8" Rebar.

- 26.77' N to set P.K. and County Tag in P.Pole.
- 99.94' NE to set P.K. and County Tag in P.Pole.
- 85.53' SE to set P.K. and County Tag in P.Pole.
- 198.91' WNW to set P.K. and County Tag in 18" Willow

Signed by *Daniel E. Johnson* Date May 22, 1995
Daniel E. Johnson

Surveyor's Michigan License No. 13754

PA 345-1990
PEER COMMITTEE

APPROVED 6-24-94 *Duke*

APPROVED AS AN OFFICIAL GOVERNMENT CORNER BY ST. CLAIR COUNTY:

Signed By: *Daniel E. Johnson* : 7-31-95
St. Clair County Land Surveyor Daniel E. Johnson Date

Surveyor's Michigan License No. 13754

LIBER 008 PAGE 101