ST. CLAIR COUNTY, MICHIGAN
OFFICIAL GOVERNMENT CORNER

LAND CORNER RECORDATION CERTIFICATE
Filing Requirement of Act 74, Mich. P.A. 1970

		Located In:		Corner Code #
		7N	14E	A-13
1. Public Land Survey		T ____	R ____	
		T ____	R ____	
		T ____	R ____	
		T ____	R ____	
2. Property Controlling	S ____	T ____	R ____	Seg. 2
in Section	S ____	T ____	R ____	
3. Miscellaneous	S ____	T ____	R ____	
Property in Sec.	S ____	T ____	R ____	

RECEIVED 1995 AUG -4 AM 10:14 REGISTER OF DEEDS ST. CLAIR COUNTY

Register of Deeds Stamp & File Number

4. Lot No. _____ , Recorded Plat _____
5. Private Claims _____

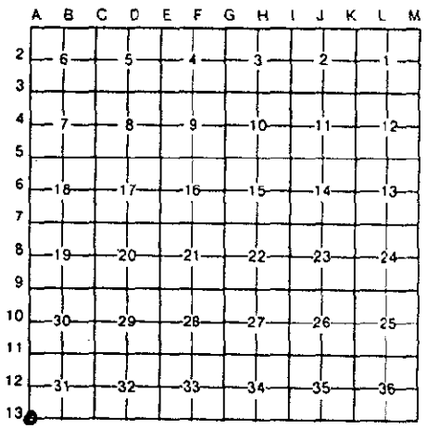

I, Daniel E. Johnson, in a field survey on May 2, 19 94, do hereby certify that under requirements of P.A. 74, Michigan P.A. of 1970, the corner points mentioned in lines 1 and 2 above were in conformance with regulations and rules therefore as required in the current manual of survey instructions of the United States Department of the Interior, Bureau of Land Management or by a decree of a Court of Law and/or that the corner points mentioned in lines 3, 4 and 5 above were in conformance with the rules of the Michigan Board of Land Surveyors or by a Decree of a Court of Law; established, re-established, monumented, re-monumented, recovered, found as expressed below:

NOTE: Not more than 1 corner, may be recorded on this certificate.

A. Description of original monument and accessories and/or subsequent restoration:

LIBER 007 PAGE 349

STATE PLAIN COORDINATES

N. _____

E. _____

ELEVATION _____

B. Description of corner evidence found and/or method applied in restoring or reestablishing corner:

LIBER 007 PAGE 349

STATE OF MICHIGAN
DANIEL E. JOHNSON
LAND SURVEYOR
13754
REGISTERED LAND SURVEYOR

C. Description of monument for corner and accessories established to perpetuate locating the position of the corner:
"ACCEPTED MICHIGAN DEPARTMENT OF TRANSPORTATION BRASS DISC"
1 1/2" brass disc on 5/8" Rod.

73.81' WNW to set P.K. and County Tag in 15" Elm
75.07' NW to set P.K. and County Tag in P.Pole (set above MDOT Tag)
83.52' NE to set P.K. and County Tag in P.Pole (set above prev. P.K.)
272.31' ESE to set P.K. and County Tag in P.Pole
17.05' E County Road PI to North

Signed by Daniel E. Johnson Date MAY 2, 1994

Surveyor's Michigan License No. Daniel E. Johnson 13754

PA 345-1990
~~PEER COMMITTEE~~
APPROVED 5-20-94 Dan

APPROVED AS AN OFFICIAL GOVERNMENT CORNER BY ST. CLAIR COUNTY:

Signed By: Daniel E. Johnson : 7-31-95
St. Clair County Land Surveyor Date

Surveyor's Michigan License No. Daniel E. Johnson 13754

LIBER 008 PAGE 94