

ST. CLAIR COUNTY, MICHIGAN OFFICIAL GOVERNMENT CORNER



LAND CORNER RECORDATION CERTIFICATE Filing Requirement of Act 74, Mich. P.A. 1970

	Located In:	Corner Code #	
1. Public Land Survey	T <u>7N</u> R <u>14E</u>	<u>D-13</u>	
	T _____ R _____	_____	
	T _____ R _____	_____	
	T _____ R _____	_____	
2. Property Controlling in Section	S _____ T _____ R _____	<u>Seg 2</u>	
	S _____ T _____ R _____	_____	
3. Miscellaneous Property in Sec.	S _____ T _____ R _____	_____	
	S _____ T _____ R _____	_____	
4. Lot No. _____, Recorded Plat _____			
5. Private Claims _____			

REGISTER OF DEEDS
ST. CLAIR COUNTY, MICHIGAN

1995 AUG -4 AM 10:14

RECEIVED

Register of Deeds Stamp & File Number

I, Daniel E. Johnson, in a field survey on May 22, 19 95, do hereby certify that under requirements of P.A. 74, Michigan P.A. of 1970, the corner points mentioned in lines 1 and 2 above were in conformance with regulations and rules therefore as required in the current manual of survey instructions of the United States Department of the Interior, Bureau of Land Management or by a decree of a Court of Law and/or that the corner points mentioned in lines 3, 4 and 5 above were in conformance with the rules of the Michigan Board of Land Surveyors or by a Decree of a Court of Law; established, re-established, monumented, re-monumented, recovered, found as expressed below:

	A	B	C	D	E	F	G	H	I	J	K	L	M
2	6	5	4	3	2	1							
3													
4	7	8	9	10	11	12							
5													
6	18	17	16	15	14	13							
7													
8	19	20	21	22	23	24							
9													
10	30	29	28	27	26	25							
11													
12	31	32	33	34	35	36							
13													

NOTE: Not more than 1 corner, may be recorded on this certificate.

A. Description of original monument and accessories and/or subsequent restoration:


LIBER 007 PAGE 343

STATE PLAIN COORDINATES

N. _____
E. _____

B. Description of corner evidence found and/or method applied in restoring or reestablishing corner:

LIBER 007 PAGE 343

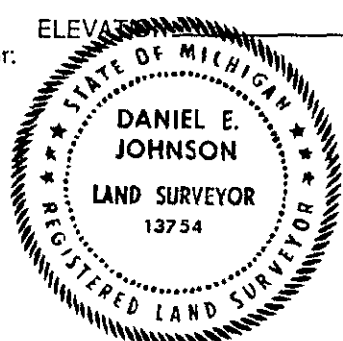

C. Description of monument for corner and accessories established to perpetuate locating the position of the corner:

Set 2" Dia. Aluminum Cap inscribed "St. Clair County Official Corner" with magnet over 1/2" Rebar.

- 123.33' SE to set P.K. and County Tag in P.Pole
- 194.96' SW to set P.K. and County Tag in P.Pole
- 59.47' NNW to set P.K. and County Tag in 6" Maple
- 82.78' NE to set P.K. and County Tag in 6" Elm

Signed by Daniel E. Johnson Date May 22, 1995
 Daniel E. Johnson
 Surveyor's Michigan License No. 13754

PA 345-1990
 PEER COMMITTEE
 APPROVED 5-20-94 *Dave*

APPROVED AS AN OFFICIAL GOVERNMENT CORNER BY ST. CLAIR COUNTY:
 Signed By: Daniel E. Johnson : 7-31-95 Date
 St. Clair County Land Surveyor Daniel E. Johnson
 Surveyor's Michigan License No. 13754